


CERTIFIED RECORD OF LAND CORNER MONUMENTATION

HISTORY OF ORIGINAL CORNER ESTABLISHED:

The Original Redfield Field Notes of the Umatilla Indian Reservation dated 1917-1919, Book #1, Umatilla County Surveyor Records shows that in 1919, Redfield, as part of the allotments and patents of the Umatilla Indian Reservation, set a monument.

T 1 N R 35 E F-19

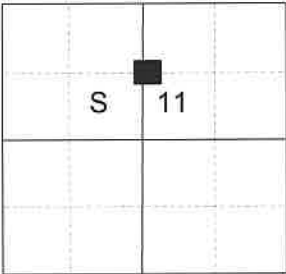

DESCRIPTION OF CORNER EVIDENCE FOUND:

Found a 2 1/2" galvanized iron pipe with with 2 1/2" brass cap, buried in ground and leaning downhill.

DESCRIPTION OF MONUMENT AND ACCESSORIES I ESTABLISHED TO PERPETUATE THE ORIGINAL LOCATION OF THIS CORNER:

At the position of the base of the iron pipe, I reset monument upright, with 4" above ground, from which:

NEW BEARING OBJECTS:


- A 3" diam. Douglas Fir bears North 80° East, a dist. of 11.90 feet, marked X BT
- A 6" diam. Douglas Fir bears South 38° East, a dist. of 14.60 feet, marked CN 1/16 S11 BT

I hereby certify that the corner was perpetuated
August 27, 2025

Witness: Kyle Tucker



Renewal Date: June 30, 2027

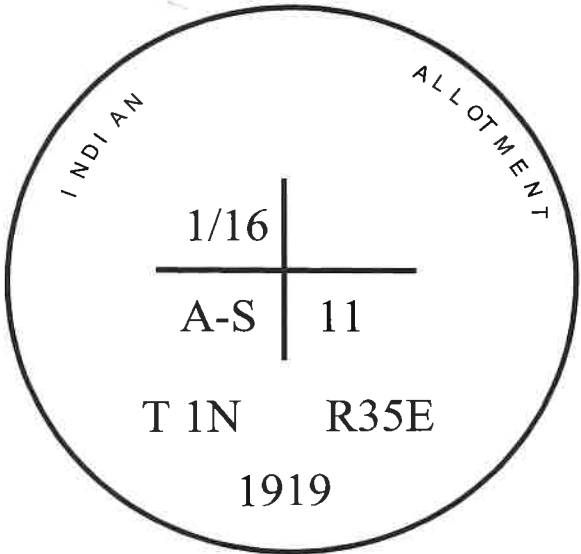

I use a tape and compass in the establishment of the new bearing trees. Bearings are measured from the center of the brass cap to a brass washer marked "OPLS 83571" tacked to the BT blaze using 14° East for declination. Distances are measured from the center of the brass cap to a 60D spike in the center right base of the tree.