


CERTIFIED RECORD OF LAND CORNER MONUMENTATION

HISTORY OF ORIGINAL CORNER ESTABLISHED:

Corner was originally established under GLO Special Joint Contract, dated May 4th, 1887, executed by Currin and Noland. Surveyor General field notes state:

Summit sharp ridge and set Basalt Stone 16x16x8 ins. 12 ins. in the ground for 1/4 sec. cor. marked 1/4 on W face, raised mound of stone over it. Pits impracticable.

The Original Redfield Field Notes of the Umatilla Indian Reservation dated 1917-1919, Book #1, Umatilla County Surveyor Records shows that in 1919, Redfield, as part of the allotments and patents of the Umatilla Indian Reservation, set a monument.

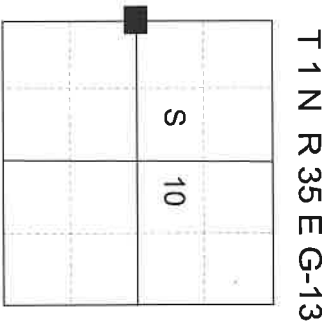

DESCRIPTION OF CORNER EVIDENCE FOUND:

Found a 2 1/2" galvanized pipe with 2 1/2" brass cap marked as shown below, 1" above ground in 4 ft. diam. mound of stone and perched on a spine ridge.

DESCRIPTION OF MONUMENT AND ACCESSORIES I ESTABLISHED TO PERPETUATE THE ORIGINAL LOCATION OF THIS CORNER:


From the iron pipe monument:

NEW BEARING OBJECTS:


- A 3/4" x 2" magnet encased in silver and black plastic bears North 42°16' East, a dist. of 21.12 feet.
- A 3/4" x 2" magnet encased in pink and black plastic bears North 49°14' East, a dist. of 23.01 feet.
- A 3/4" x 2" magnet encased in blue and black plastic bears North 33°38' East, a dist. of 21.64 feet.
- A 3/4" x 2" magnet encased in orange and black plastic bears North 50°25' East, a dist. of 22.15 feet.

I hereby certify that the corner was perpetuated September 15, 2025

Witness: Kyle Tucker

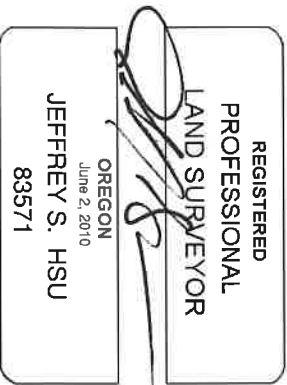

Renewal Date: June 30, 2027

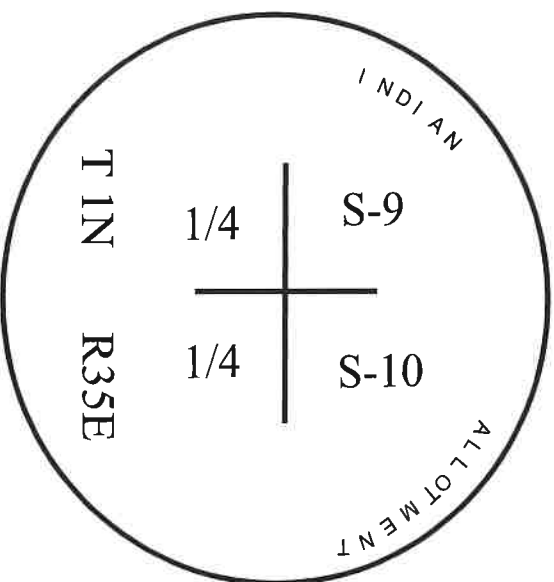

I use a Leica GS18 with RTK in the establishment of the new bearing objects. Basis of bearing is as per map of survey filed concurrently. Bearings and distances are measured from the center of the brass cap to the center of the magnets. Magnets buried 6" with colored side facing upwards.