


CERTIFIED RECORD OF LAND CORNER MONUMENTATION

HISTORY OF ORIGINAL CORNER ESTABLISHED:

The Original Redfield Field Notes of the Umatilla Indian Reservation dated 1917-1919, Book #1, Umatilla County Surveyor Records shows that in 1919, Redfield, as part of the allotments and patents of the Umatilla Indian Reservation, set a monument.

T 1 N R 35 E G-14

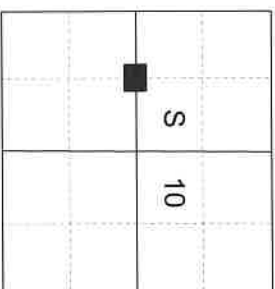

DESCRIPTION OF CORNER EVIDENCE FOUND:

Found a 2 1/2" galvanized iron pipe, leaning downhill, with 2 1/2" brass cap marked as shown below, in a 3' diam. mound of stone.

DESCRIPTION OF MONUMENT AND ACCESSORIES I ESTABLISHED TO MONUMENT THE ORIGINAL LOCATION OF THIS CORNER:


At the position of the base of found pipe, I set pipe upright, 8" in the ground, and build a 4' diam. mound of stone base to top of cap from which:

NEW BEARING OBJECTS:


A 3/4" x 2" magnet encased in pink and black plastic bears South 48°46' East, a dist. of 13.38 feet.
A 3/4" x 2" magnet encased in blue and black plastic bears South 62°09' West, a dist. of 12.36 feet.

I hereby certify that the corner was monumented
September 15, 2025

Witness: Kyle Tucker

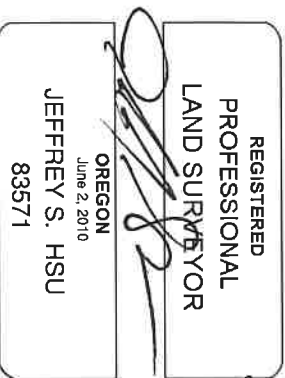

Renewal Date: June 30, 2027

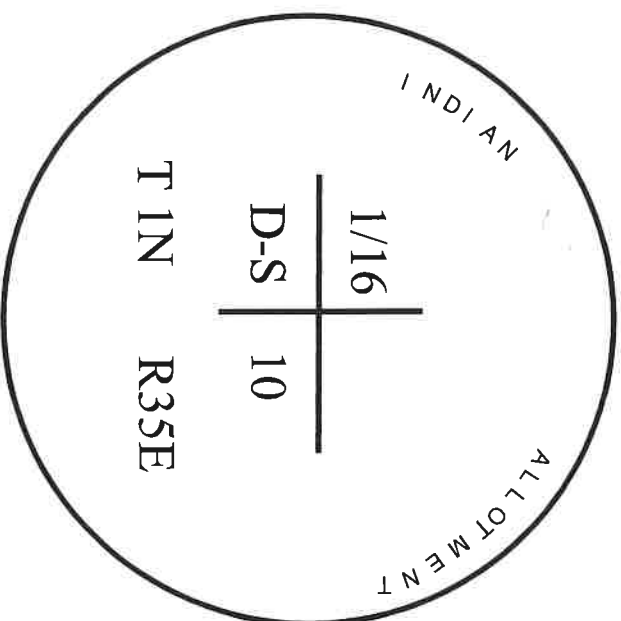

I use a Leica GS18 with RTK in the establishment of the new bearing objects. Basis of Bearing is as per map of survey filed concurrently. Bearings and distances are measured from the center of the brass cap to the center of the magnets. Magnets buried 6" with colored side facing upwards.