


CERTIFIED RECORD OF LAND CORNER MONUMENTATION

HISTORY OF ORIGINAL CORNER ESTABLISHED:

The Original Redfield Field Notes of the Umatilla Indian Reservation dated 1917-1919, Book #1, Umatilla County Surveyor Records shows that in 1919, Redfield, as part of the allotments and patents of the Umatilla Indian Reservation, set a monument.

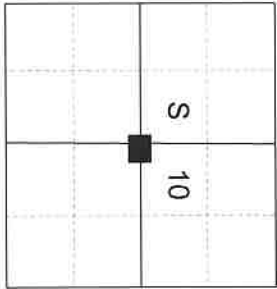

T 1 N R 35 E G-15

DESCRIPTION OF CORNER EVIDENCE FOUND:

Found a 2 1/2" galvanized iron pipe, 30" above ground, with 2 1/2" brass cap marked as shown below, in a 4' diam. degraded mound of stone.

DESCRIPTION OF MONUMENT AND ACCESSORIES I ESTABLISHED TO PERPETUATE THE ORIGINAL LOCATION OF THIS CORNER:

At the found iron pipe I rebuild the 4' diam. stone mound base to top of cap, from which:

NEW BEARING OBJECTS:

- A 3/4" x 2" magnet encased in silver and black plastic bears North 35°36' East, a dist. of 19.44 feet.
- A 3/4" x 2" magnet encased in pink and black plastic bears South 50°48' East, a dist. of 16.54 feet.
- A 3/4" x 2" magnet encased in blue and black plastic bears South 45°58' West, a dist. of 16.05 feet.
- A 3/4" x 2" magnet encased in orange and black plastic bears North 56°19' West, a dist. of 13.93 feet.


I hereby certify that the corner was monumented September 15, 2025

Witness: Kyle Tucker

REGISTERED
PROFESSIONAL
LAND SURVEYOR


OREGON
June 2, 2010
JEFFREY S. HSU
83571

Renewal Date: June 30, 2027

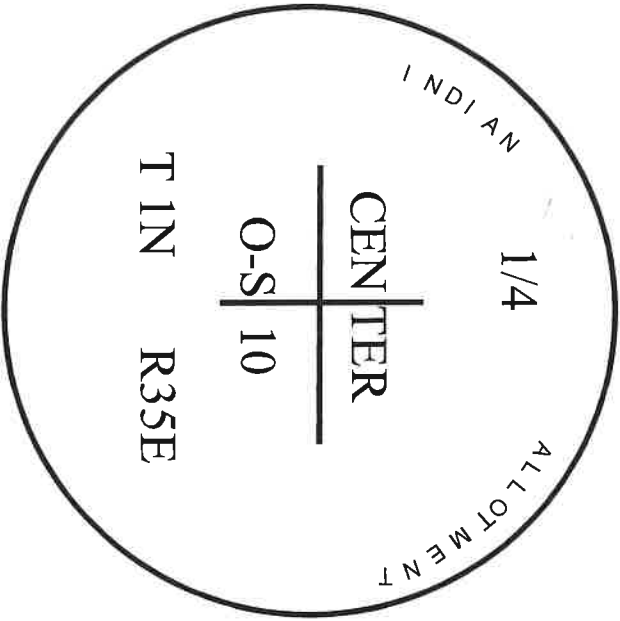

I use a Leica GS18 with RTK in the establishment of the new bearing objects. Basis of Bearing is as per map of survey filed concurrently. Bearings and distances are measured to from the center of the brass cap to the center of the magnets. Magnets buried 6" with colored side facing upwards.