

CERTIFIED RECORD OF LAND CORNER MONUMENTATION


HISTORY OF ORIGINAL CORNER ESTABLISHED:

Corner was originally established under GLO Special Joint Contract, dated May 4th, 1887, executed by Currin and Noland. Surveyor General field notes state:

Set Basalt Stone 12 x 17 x 6 ins., 10 ins. in the ground for 1/4 S. Cor. marked 1/4 on W. face. raised mound of stone over it. Pits impracticable.

The Original Redfield Field Notes of the Umatilla Indian Reservation dated 1917-1919, Book #1, Umatilla County Surveyor Records shows that in 1919, Redfield, as part of the allotments and patents of the Umatilla Indian Reservation, set a monument.

T 1 N R 35 E G-17

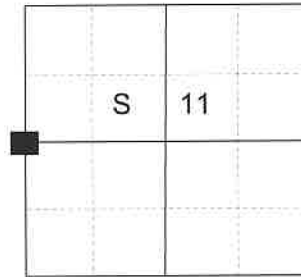

DESCRIPTION OF CORNER EVIDENCE FOUND:

Found an 11" x 17" x 6" stone marked 1/4 in 4' diam. collar of stone with a 2 1/2" x 36" galvanized iron pipe with 2 1/2" brass cap leaning overtop.

DESCRIPTION OF MONUMENT AND ACCESSORIES I ESTABLISHED TO PERPETUATE THE ORIGINAL LOCATION OF THIS CORNER:

At the center of the found stone I set the found 2 1/2" x 36" galvanized iron pipe, 12" in the ground, with 2 1/2" brass cap marked as shown below, in a 4' diam. mound of stone base to within 4" of cap, and bury found stone alongside, from which:


NEW BEARING OBJECTS:

A 3/4" x 2" magnet encased in silver and black plastic bears North 35°50' East, a dist. of 17.40 feet.

A 3/4" x 2" magnet encased in pink and black plastic bears South 42°20' East, a dist. of 16.02 feet.

A 3/4" x 2" magnet encased in blue and black plastic bears South 40°06' West, a dist. of 17.85 feet.

A 3/4" x 2" magnet encased in orange and black plastic bears North 44°23' West, a dist. of 16.83 feet.

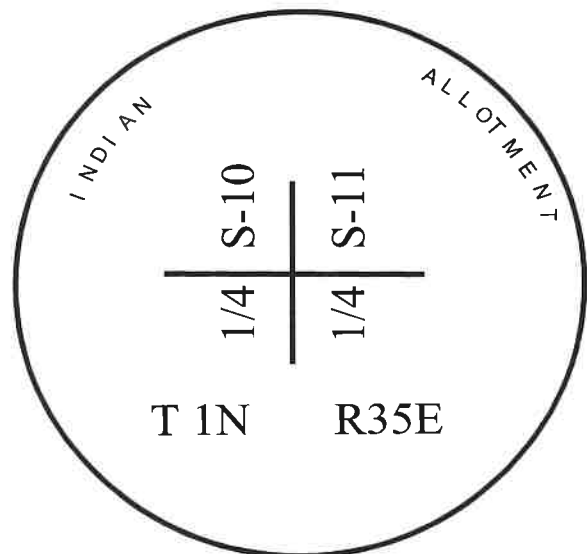

I hereby certify that the corner was perpetuated August 27 2025

Witness: Kyle Tucker



Renewal Date: June 30, 2027

I use a Leica GS18 with RTK in the establishment of the new bearing objects. Basis of Bearing is as per map of survey filed concurrently. Bearings and distances are measured from the center of the brass cap to the center of the magnets. Magnets buried 6".