


CERTIFIED RECORD OF LAND CORNER MONUMENTATION

HISTORY OF ORIGINAL CORNER ESTABLISHED:

The Original Redfield Field Notes of the Umatilla Indian Reservation dated 1917-1919, Book #1, Umatilla County Surveyor Records shows that in 1919, Redfield, as part of the allotments and patents of the Umatilla Indian Reservation, set a monument.

T 1 N R 35 E G-18

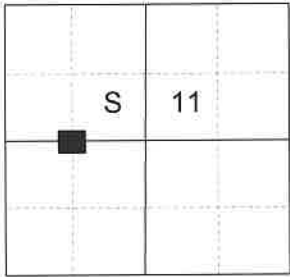

DESCRIPTION OF CORNER EVIDENCE FOUND:

Found an uprooted 2 1/2" galvanized iron pipe with 2 1/2" brass cap lying on a ridge top with scattered stone.

DESCRIPTION OF MONUMENT AND ACCESSORIES I ESTABLISHED TO MONUMENT THE ORIGINAL LOCATION OF THIS CORNER:

At proportionate position by Survey I set a 5/8" x 20" iron pin, 15" drilled into rock, with 2 1/2" aluminum cap marked as shown below, and in a 3' diam. mound of stone, from which:

NEW BEARING OBJECTS:

A 5/8" x 15" iron pin bears South 11°30' East, a dist. of 13.85 feet, with 1 1/2" aluminum cap marked BGB SURVEY MARKER S RP.


A 5/8" x 15" iron pin bears North 71°10' West, a dist. of 44.69 feet, with 1 1/2" aluminum cap marked BGB SURVEY MARKER N RP.

Buried original monument on South side.

Set Steel fence post approx. 0.3 feet North

I hereby certify that the corner was monumented September 10, 2025

Witness: Kyle Tucker

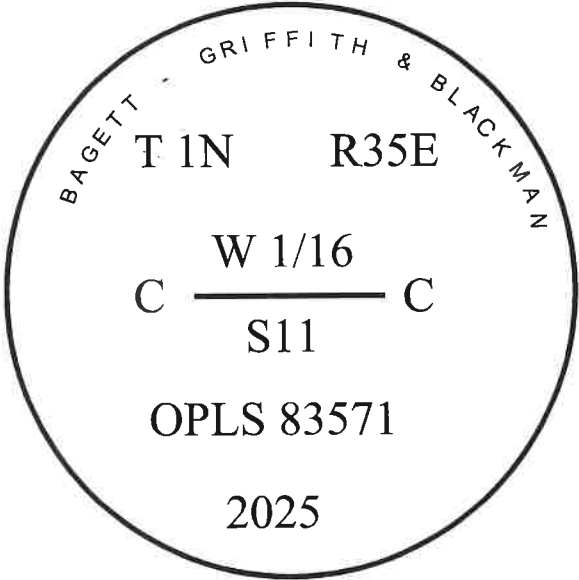

Renewal Date: June 30, 2027

I use a Leica GS18 with RTK in the establishment of the new bearing objects. Basis of Bearing is as per map of survey filed concurrently. Bearings and distances are measured to the center of the aluminum caps.