


CERTIFIED RECORD OF LAND CORNER MONUMENTATION

HISTORY OF ORIGINAL CORNER ESTABLISHED:

The Original Redfield Field Notes of the Umatilla Indian Reservation dated 1917-1919, Book #1, Umatilla County Surveyor Records shows that in 1919, Redfield, as part of the allotments and patents of the Umatilla Indian Reservation, set a monument.

T 1 N R 35 E G-19

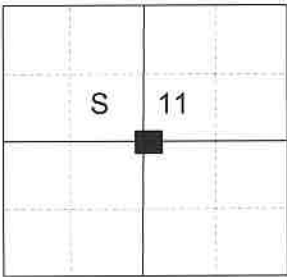

DESCRIPTION OF CORNER EVIDENCE FOUND:

Found a 2 1/2" galvanized iron pipe with with 2 1/2" brass cap, 10" above ground, in 2' diam. mound of stone.

DESCRIPTION OF MONUMENT AND ACCESSORIES I ESTABLISHED TO PERPETUATE THE ORIGINAL LOCATION OF THIS CORNER:


From the iron pipe monument:

NEW BEARING OBJECTS:

- A 2' x 2' x 6" exposed rock bears North 44° East, a dist. of 19.70 feet, marked X BO.
- A 7" diam. Douglas Fir bears South 56° East, a dist. of 23.80 feet, marked C 1/4 S11 BT.
- A 20" diam. Douglas Fir bears South 64° West, a dist. of 23.70 feet, marked C 1/4 S11 BT.
- A 2" diam. Douglas Fir bears North 58° West, a dist. of 33.75 feet, marked X BT.

I hereby certify that the corner was perpetuated August 27, 2025

Witness: Kyle Tucker

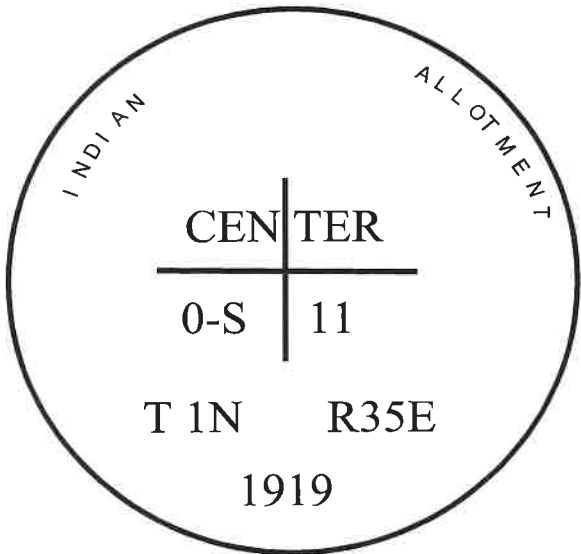

I use a tape and compass in the establishment of the new bearing trees. Bearings are measured from the center of the brass cap to a brass washer marked "OPLS 83571" tacked to the BT blaze using 14° East for declination. Distances are measured from the center of the brass cap to a 60D spike in the center right base of the tree. Bearing and distance of the chiseled rock is to the center of the X.