

CERTIFIED RECORD OF LAND CORNER MONUMENTATION

HISTORY OF ORIGINAL CORNER ESTABLISHED:

The Original Redfield Field Notes of the Umatilla Indian Reservation dated 1917-1919, Book #1, Umatilla County Surveyor Records shows that in 1919, Redfield, as part of the allotments and patents of the Umatilla Indian Reservation, set a monument.

	S	10

T 1 N R 35 E H-13

DESCRIPTION OF CORNER EVIDENCE FOUND:

Found a 2 1/2" galvanized iron pipe, 18" above ground, with 2 1/2" brass cap marked as shown below, in a 2' diam. mound of stone.

DESCRIPTION OF MONUMENT AND ACCESSORIES I ESTABLISHED TO MONUMENT THE ORIGINAL LOCATION OF THIS CORNER:

From the iron pipe monument:


NEW BEARING OBJECTS:

A 4" diam. White Fir bears South 80° East, a dist. of 8.50 feet, marked S 1/16 S10 BT
A 9" diam. Douglas Fir bears North 66° West, a dist. of 19.60 feet, marked S 1/16 S9 BT

Set steel fence post approx. 1 ft. South

I hereby certify that the corner was monumented September 15, 2025

Witness: Kyle Tucker

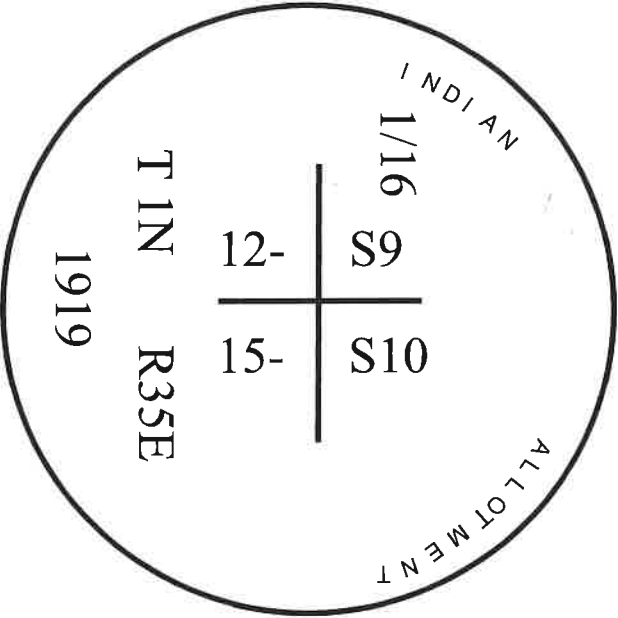

I use a tape and compass in the establishment of the new bearing trees. Bearings are measured from the center of the brass cap to a brass washer marked "OPLS 83571" tacked to the BT blaze using 14° East for declination. Distances are measured from the center of the brass cap to a 60D spike in the center right base of the tree.