

CERTIFIED RECORD OF LAND CORNER MONUMENTATION

HISTORY OF ORIGINAL CORNER ESTABLISHED:

The Original Redfield Field Notes of the Umatilla Indian Reservation dated 1917-1919, Book #1, Umatilla County Surveyor Records shows that in 1919, Redfield, as part of the allotments and patents of the Umatilla Indian Reservation, set a monument.

T 1 N R 35 E J-14

	S	10

DESCRIPTION OF CORNER EVIDENCE FOUND:

Found a 2 1/2" galvanized iron pipe with with 2 1/2" brass cap, 13" above ground.

Fence post approx. 2 ft. East

DESCRIPTION OF MONUMENT AND ACCESSORIES I ESTABLISHED TO PERPETUATE THE ORIGINAL LOCATION OF THIS CORNER:


From the iron pipe monument:

NEW BEARING OBJECTS:


A 3/4" x 2" magnet encased in silver and black plastic bears North 81° East, a dist. of 10.59 feet.
A 3/4" x 2" magnet encased in orange and black plastic bears North 11°43' West, a dist. of 9.74 feet.

I hereby certify that the corner was perpetuated
September 16, 2025

Witness: Kyle Tucker

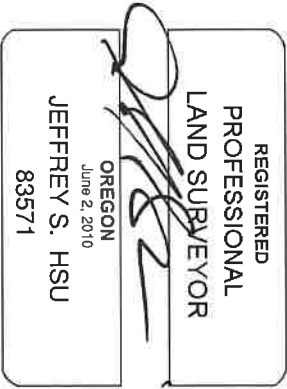

Renewal Date: June 30, 2027

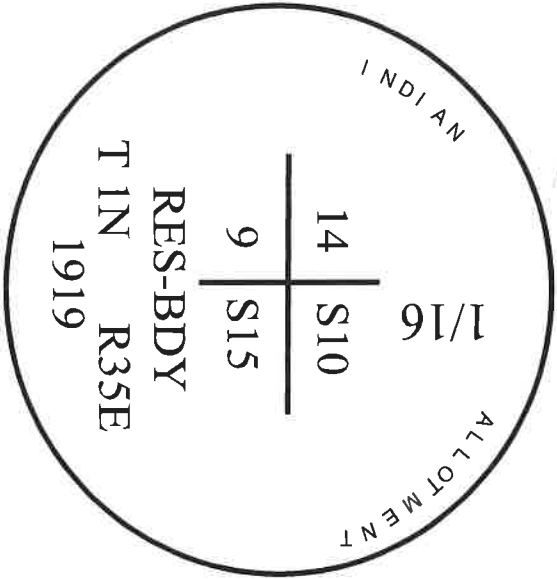

I use a Leica GS18 with RTK in the establishment of the new magnet bearing objects. Basis of Bearing is as per map of survey filed concurrently. Bearings and distances are measured from the center of the brass cap to the center of the magnets. Magnets buried 6" with colored end facing upwards.