

CERTIFIED RECORD OF LAND CORNER MONUMENTATION

HISTORY OF ORIGINAL CORNER ESTABLISHED:

Corner was originally established under GLO Special Joint Contract, dated May 4th, 1887, executed by Currin and Noland. Surveyor General field notes state:

Set Basalt Stone 10 x 10 x 10 ins. in the ground for 1/4 sec. cor. marked 1/4 S on N. face, raised mound of stone over it. Pits impracticable.


Corner monumented by L. E. Wilkes under GLO Special Instructions, Group No. 29, for the Resurvey of the East, South, West, and Western three miles of North Boundary of the Diminished Umatilla Indian Reservation, dated Feb. 20, 1917. Surveyor General field notes state:

Apportioned distance

Set an iron post, 3 ft. long, 2 ins. diam., 24 ins. in the ground, for 1/4 sec. cor., with brass cap marked: from which:

A fir, 16 ins. diam., bears N.25°E., 271 lks. dist., marked 1/4 S 10 BT.
No other tree available; raise a mound of stone, 2 ft. base 1 1/2 ft. high, N. of cor.

The Original Redfield Field Notes of the Umatilla Indian Reservation dated 1917-1919, Book #1, Umatilla County Surveyor Records shows that in 1919, Redfield, as part of the allotments and patents of the Umatilla Indian Reservation, notes a monument.

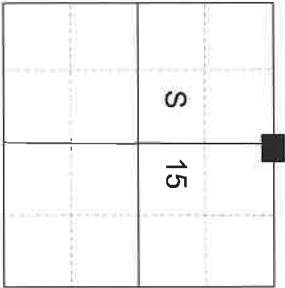

T 1 N R 35 E J-15

DESCRIPTION OF CORNER EVIDENCE FOUND:

Found a 2 1/2" galvanized iron pipe, 8" above ground, with 2 1/2" brass cap marked as shown below.

Fencepost approx. 2' Northeasterly

DESCRIPTION OF MONUMENT AND ACCESSORIES I ESTABLISHED TO PERPETUATE THE ORIGINAL LOCATION OF THIS CORNER:

From the iron pipe monument:

NEW BEARING OBJECTS:

- A 16" diam. Douglas Fir bears North 77° East, a dist. of 5.65 feet, marked 1/4 S10 BT
- A 7" Douglas Fir bears South 35° East, a dist. of 4.95 feet, marked 1/4 S15 BT
- A 3/4" x 2" magnet encased in blue and black plastic bears South 56°44' West, a dist. of 23.57 feet.
- A 3/4" x 2" magnet encased in orange and black plastic bears North 85°58' West, a dist. of 22.68 feet.

I hereby certify that the corner was perpetuated
September 15, 2025


Witness: Kyle Tucker

REGISTERED
PROFESSIONAL
LAND SURVEYOR

OREGON
June 2, 2010

JEFFREY S. HSU
83571

Renewal Date: June 30, 2027

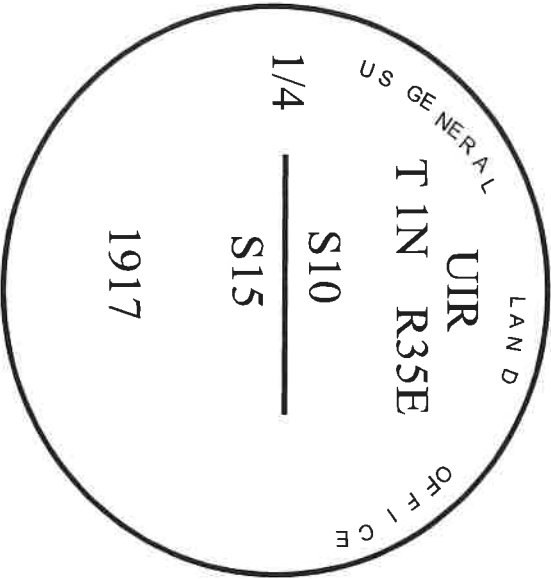

I use a Leica GS18 with RTK in the establishment of the new magnet bearing objects. Basis of Bearing is as per map of survey filed concurrently. Bearings and distances are measured from the center of the brass cap to the center of the magnets. Magnets buried 6" with colored side facing upwards. I use a tape and compass in the establishing of the new bearing trees. Bearings are measured from the center of the brass cap to a brass washer marked "OPLS 83571" tacked to the BT blaze using 14° East for declination. Distances are measured from the center of the brass cap to a 60D spike in the center right base of the tree.