

CERTIFIED RECORD OF LAND CORNER MONUMENTATION


HISTORY OF ORIGINAL CORNER ESTABLISHED:

Corner was originally established under GLO contract number No. 635, dated April 19th, 1895, executed by Manius Buchanan. Surveyor General field notes state:

Set a basalt stone 18x10x6 ins. in mound of stone, on rock, marked 1/4 on North face, and raised a mound of stone, 2 ft. base, and 1 1/2 ft. high, N. of cor. Pits impracticable. This cor. is on summit of a ridge

In 1971 the BLM noted on a corner record card: "Not a legal proportion, Set corner 1/2 way between sec. corners. The corner is a steel post with a location tag attached. Set a large mound of stone at the base of the post. Is adjacent to a large rock jack in the Forest Service fence.

T 1 N R 35 E J-23

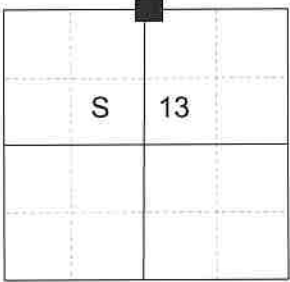

DESCRIPTION OF CORNER EVIDENCE FOUND:


Found an 18" x 10"-x 4" stone marked '1/4' loose in South side of rock jack from which fences bear East/West along on the South side. Remnants of an ancient fence line up with the West side of the rock jack. An embedded 2 foot mound of stone falls 5 feet North of the Southeast corner of the rock jack with a steel post and location tag in the center of it.

DESCRIPTION OF MONUMENT AND ACCESSORIES I ESTABLISHED TO MONUMENT THE ORIGINAL LOCATION OF THIS CORNER:

At the Southeast corner of the rock jack I set a 5/8" x 20" iron pin, 18" drilled in the rock, with 2 1/2" aluminum cap marked as shown, from which:

NEW BEARING OBJECTS:

A 3/4" x 2" magnet encased in silver and black plastic bears North 49°06' East, a dist. of 24.06 feet.
A 3/4" x 2" magnet encased in pink and black plastic bears South 53°57' East, a dist. of 20.59 feet.
A 3/4" x 2" magnet encased in blue and black plastic bears South 36°43' West, a dist. of 11.50 feet.
A 3/4" x 2" magnet encased in orange and black plastic bears North 32°21' West, a dist. of 24.87 feet, marked SurvKap

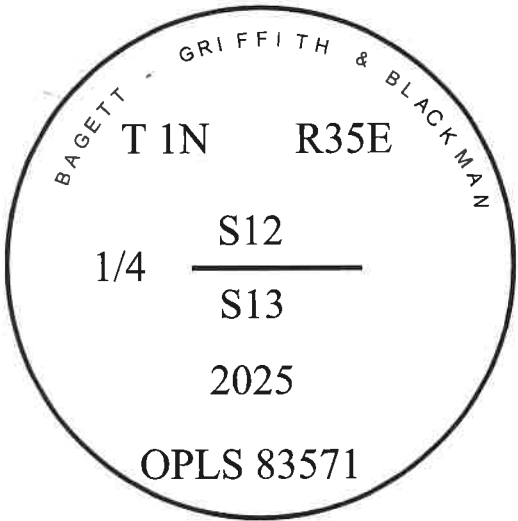

I hereby certify that the corner was September 22, 2025

Witness: Kyle Tucker



Renewal Date: June 30, 2027

I use a Leica GS18 with RTK in the establishment of the new bearing objects. Basis of Bearing is as per map of survey filed concurrently. Bearings and distances are measured from the center of the brass cap to the center of the magnets. Magnets buried 6" deep with colored side facing upwards.

J-23

25-086-8