

CERTIFIED RECORD OF LAND CORNER MONUMENTATION

HISTORY OF ORIGINAL CORNER ESTABLISHED:

Corner was originally established under GLO contract number No. 635, dated April 19th, 1895, executed by Manius Buchanan. Surveyor General field notes state:


Set a basalt stone 18x12x8 ins. in mound of stone, on rock, marked 1/4 on West face, from which:

A pine 15" diam. bear N57E 161 lks,

No tree within limits in Sec. 14.

Raise a mound of stone, 2 ft. base, 1 1/2 high W. Pits impracticable. This corner is on top of a ridge

T 1 N R 35 E L-21

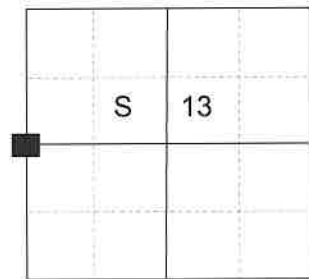

In 1982 BLM Surveyor Joseph Garrison, under Special Instructions Group Number 1000 dated July 6th, 1982, found the original stone. BLM records state: The 1/4 sec. cor. of secs. 13

and 14, monumented with the original basalt ston, 16 x 10 x 5 in., loosely set 3 ins. in

the ground, mkd. 1/4 on W. face, from which the original bearing tree:

A pine, 30 ins. diam., bears N. 60 1/2° E., 161 lks. dist., with healed double blaze.

At the corner point: Set an aluminum post, 28 ins. long, 2 1/2 ins. diam., 24 ins. in the ground, in a mound of stone, 2 1/2 ft. base, to top with aluminum cap, from which a new bearing tree:

A pine, 11 ins. diam., bears S. 37 1/2° W., 122 lks. dist., mkd. 1/4 S14 BT.

Deposit corner stone alongside aluminum post


DESCRIPTION OF CORNER EVIDENCE FOUND:

Found a 2 1/2" aluminum pipe with 3" aluminum cap marked as shown below, 1" above ground in 3 ft. diam. mound of stone, from which:

An 18" double bole Ponderosa Pine bears South 37° West, a dist. of 80.50 ft., alive and vigorous with healed blaze.

A 32" Ponderosa Pine bears North 55° East, a dist. of 106.25 ft., alive and vigorous with healed blaze.

A fence post with location tag bears approx. 5 ft. West

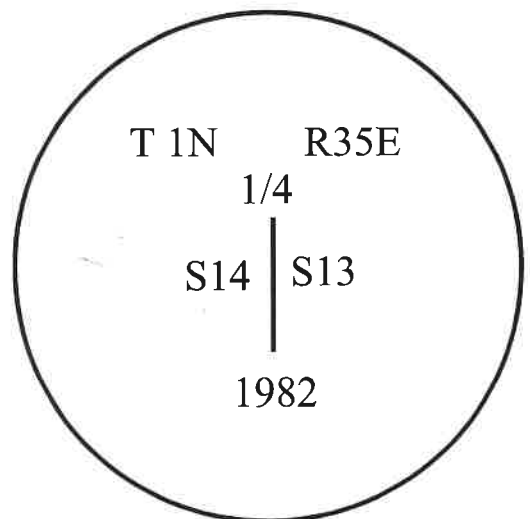

DESCRIPTION OF MONUMENT AND ACCESSORIES I ESTABLISHED TO PERPETUATE THE ORIGINAL LOCATION OF THIS CORNER:

From the aluminum monument:



NEW BEARING OBJECTS:

A 19" Ponderosa Pine bears South 23° East, a dist. of 10.60 feet, marked 1/4 S13 BT

A 7" Ponderosa Pine bears North 26° West, a dist. of 6.65 feet, marked 1/4 S14 BT

I hereby certify that the corner was perpetuated September 10, 2025

Witness: Kyle Tucker

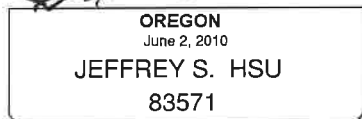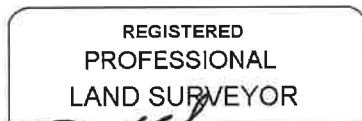

Renewal Date: June 30, 2027

I use a tape and compass in the establishment of the new bearing trees. Bearings are measured from the center of the aluminum cap to a brass washer marked "OPLS 83571" tacked to the BT blaze using 14° East for declination. Distances are measured to from the center of the aluminum cap to a 60D spike in the center right base of the tree.

L-21

25-086-8