


CERTIFIED RECORD OF LAND CORNER MONUMENTATION

HISTORY OF ORIGINAL CORNER ESTABLISHED:

Corner not previously established

T 1 N R 35 E L-23

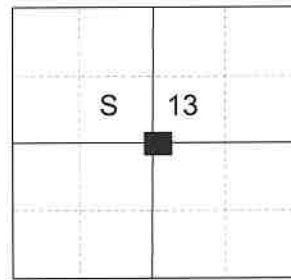

DESCRIPTION OF CORNER EVIDENCE FOUND:

Found a fence post with BLM tag stating "2640' from 1/4 East and West by chain and transit", which bears North 82° West approx. 4.5 feet from the new monument

DESCRIPTION OF MONUMENT AND ACCESSORIES I ESTABLISHED TO MONUMENT THE ORIGINAL LOCATION OF THIS CORNER:


At position by survey I set a 5/8" x 30" iron pin, 26" in the ground with 2 1/2" aluminum cap marked as shown below, from which:

NEW BEARING OBJECTS:

A 15" diam. White Fir bears North 49° East, a dist. of 19.65 feet, marked C 1/4 S13 BT
A 6" diam. Douglas Fir bears South 71° East, a dist. of 8.55 feet, marked C 1/4 S13 BT
A 5" diam. Douglas Fir bears South 66° West, a dist. of 13.83 feet, marked C 1/4 S13 BT
A 9" diam. Douglas Fir bears North 5° West, a dist. of 5.70 feet, marked C 1/4 S13 BT

I hereby certify that the corner was monumented on September 22, 2025

Witness: Kyle Tucker

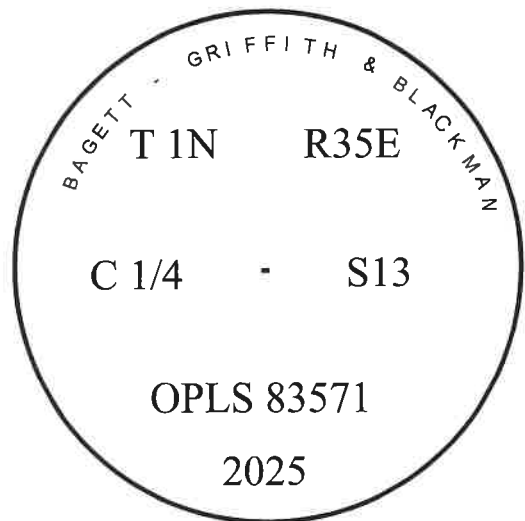

Renewal Date: June 30, 2027

I use a tape and compass in the establishment of the new bearing trees. Bearings are measured from the center of the aluminum cap to a brass washer marked "OPLS 83571" tacked to the BT blaze using 14° East for declination. Distances are measured to from the center of the aluminum cap to a 60D spike in the center right base of the tree.

L-23

25-086-8