


**CERTIFIED RECORD OF LAND CORNER MONUMENTATION**

**HISTORY OF ORIGINAL CORNER ESTABLISHED:**

Corner originally established under special contract, executed by Currin and Noland, dated May 4, 1887. Surveyor General field notes state: Set post 3 ft. long, 3 ins. square, 24" in the ground, for 1/4 sec. cor. mkd. 1/4S on N. face from which:  
A fir 10 ins. diam. bears N77°W 62 lks dist. mkd. 1/4 SBT  
A fir 12 ins. diam. bears S48°E 65 lks dist. mkd. 1/4 SBT

T 1 N R 35 E N-19

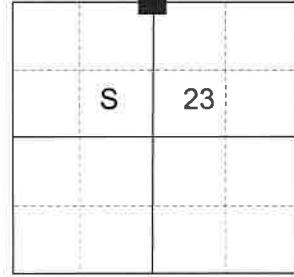

**DESCRIPTION OF CORNER EVIDENCE FOUND:**

None found.

**DESCRIPTION OF MONUMENT AND ACCESSORIES I ESTABLISHED TO PERPETUATE THE ORIGINAL LOCATION OF THIS CORNER:**

At position by Survey I set a 2 1/2" x 30" aluminum pipe, 26" in the ground, with 3" aluminum cap marked as shown below, in a mound of stone 2 ft. diam., from which:

**NEW BEARING OBJECTS:**

A 14" Douglas Fir bears North 34° East, a dist. of 14.90 ft., marked 1/4 S14 BT.  
A 12" Douglas Fir bears South 44° East, a dist. of 6.60 ft., marked 1/4 S23 BT.  
A 10" Douglas Fir bears South 80° West, a dist. of 20.60 ft., marked 1/4 S23 BT.  
An 6" White Fir bears North 41° West, a dist. of 27.95 ft., marked 1/4 S14 BT.


Set steel fence post approx. 1 ft. East

I hereby certify that the corner was monumented on September 21, 2021.

Witness: Kyle A. Tucker, Emmitt Ambert



Renewal Date: June 30, 2023

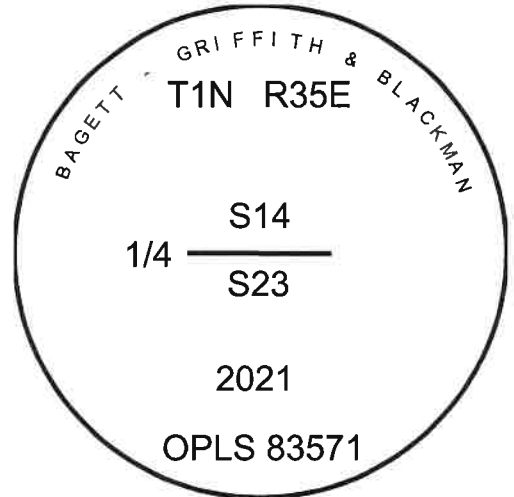

I used a steel tape and magnetic compass in the establishment of the new accessories. I used 14° East declination. Distances are to a 60d spike driven into the right side of the root crown of the bearing trees. Bearings are to a brass washer marked OPLS 83571 in the BT blaze of the new bearing trees.