


CERTIFIED RECORD OF LAND CORNER MONUMENTATION

HISTORY OF ORIGINAL CORNER ESTABLISHED:

Corner was originally established under GLO contract number No. 635, dated April 19th, 1895, executed by Manius Buchanan. Surveyor General field notes state:

Set a fir post-3 ft. long, 3 ins. square, 24 ins. in the ground for 1/4 sec. cor., marked 1/4 S. on N. face; from which,
A Fir 9 ins. diam. bears N84°W 24 lks. dist. marked 1/4 S. B.T.
A Fir 9 ins. diam. bears S65 1/2°E 75 lks. dist. marked 1/4 S. B.T.

T 1 N R 35 E N-23

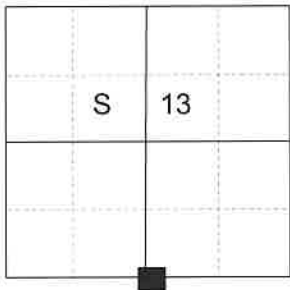

DESCRIPTION OF CORNER EVIDENCE FOUND:


None found.
A BLM approx. tag bears Northwesterly approx. 15 ft., fastened to a fence post. An East/West running fence line bears approx. 35' South

DESCRIPTION OF MONUMENT AND ACCESSORIES I ESTABLISHED TO MONUMENT THE ORIGINAL LOCATION OF THIS CORNER:

At proportionate position, I set a 2 1/2" x 30" aluminum pipe, 26" in the ground, with 3" aluminum cap marked as shown below, from which:

NEW BEARING OBJECTS:

A 10" diam. White Fir bears North 71° East, a dist. of 10.05 feet, marked 1/4 S13 BT
A 3" diam. White Fir bears South 3° East, a dist. of 18.90 feet, marked X BT
A 24" diam. White Fir bears South 19° West, a dist. of 36.50 feet, marked 1/4 S24 BT
A 9" diam. White Fir bears North 34° West, a dist. of 5.60 feet, marked 1/4 S13 BT

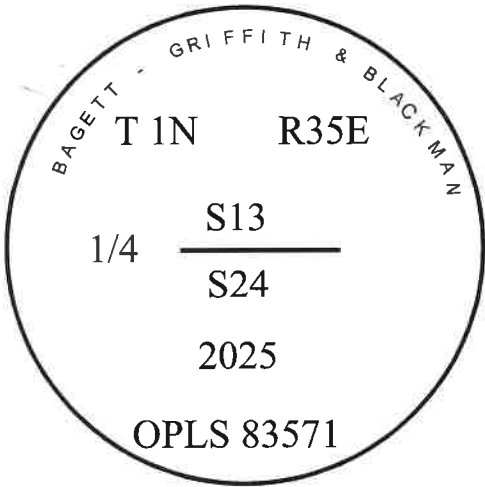

I hereby certify that the corner was monumented September 16, 2025

Witness: Kyle Tucker



Renewal Date: June 30, 2027

I use a tape and compass in the establishment of the new bearing trees. Bearings are measured from the center of the aluminum cap to a brass washer marked "OPLS 83571" tacked to the BT blaze using 14° East for declination. Distances are measured from the center of the aluminum cap to a 60D spike in the center right base of the tree.

N-23

25-086-8