


CERTIFIED RECORD OF LAND CORNER MONUMENTATION

HISTORY OF ORIGINAL CORNER ESTABLISHMENT:

Corner originally established by Currin and Noland under GLO special contract dated May 4, 1887. Surveyor General record states:
Set post 4 ft. long, 4 ins. square, 24 ins. in the ground for cor to Secs 17, 18, 19 and 20, from which:

T 1 N R 35 E N-05

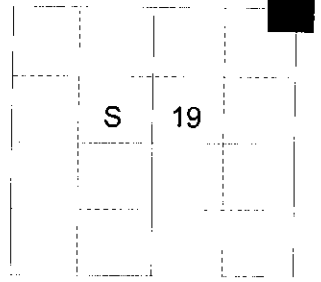

- A fir 18 ins. diam., bears N25°E, 17 lks. dist., marked T1N S17 BT.
- A fir 6 ins. diam., bears S30°E, 25 lks. dist., marked R35E S20 BT.
- A fir 10 ins. diam., bears S10°W, 38 lks. dist., marked T1N S19 BT.
- A fir 12 ins. diam., bears N20°W 10 lks. dist., marked R35E S18 BT.

In 1975, Chris Palmer, in Survey filed as M-045-C (also 03-274-C) does not find the corner as places this corner by double proportion.

In 1976, Dave Krumbain, in Survey filed as M-015-A and M-105-A, uses the position as computed by Wayne Harris (stamped by Chris Palmer).

In 2008, Steve Haddock places the corner by double proportion in Survey Number 08-145-B. Monumentation record 08-145-B states:

At proportionate position, I set a 1 1/4" x 30" galvanized iron pipe with a 2 1/4" brass cap 32 inches in the ground. For references I set four 5/8" by 24" rebars with 1 1/8" orange plastic caps, stamped WTS and 56295LS as described below:
an iron rebar bears N67°51'08"E, 35.22 feet;
an iron rebar bears N57°05'21"W, 37.57 feet;
an iron rebar bears S41°16'08"W, 34.40 feet;
an iron rebar bears S28°58'11"E, 52.92 feet;

In Survey 10-131-B, William Wells finds the corner set by Haddock destroyed and reestablishes the position by references.

DESCRIPTION OF CORNER EVIDENCE FOUND:

Corner has been removed. I reestablish the corner position by rebar references.

- An iron rebar with orange plastic cap marked WTS 56295LS bears North 67°53' East, a distance of 35.22 feet.
 - An iron rebar with orange plastic cap marked WTS 56295LS bears South 28°57' East, a distance of 52.92 feet.
 - An iron rebar with orange plastic cap marked WTS 56295LS bears North 57°09' West, a distance of 37.57 feet.
- No remains of the Southwest rebar accessory.

DESCRIPTION OF MONUMENT AND ACCESSORIES I ESTABLISHED

TO PERPETUATE THE ORIGINAL LOCATION OF THIS CORNER:

From the position as established from rebar references, I set a 5/8" x 30" iron pin with a 2 1/2" aluminum cap, marked as shown below, 33 inches in the ground, from which:

NEW ACCESSORIES:

A 5/8" x 30" iron rebar bears South 40°54' West, a distance of 24.47 feet, with 1 1/2" aluminum cap marked SW RP.


Corner falls approximately along the East side of a North/South running logging road. I set a steel fencepost approximately 12 feet West of corner monument.

I hereby certify that the corner was perpetuated on August 20, 2013.

REGISTERED
PROFESSIONAL
LAND SURVEYOR

Jeffrey S. Hsu
OREGON
June 2, 2010
JEFFREY S. HSU
83571

Renewal Date: June 30, 2015

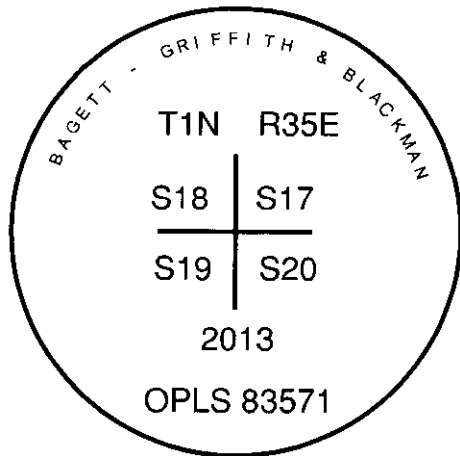

I used an Leica 1200 RTK GPS in the recovery and establishment of the accessories. Measurements are to the center of the caps. Basis of bearing is true geodetic North at the Southwest corner of Section 18, Township 1 North, Range 35 East of the Willamette Meridian as established by GPS observation.

RECEIVED BY
Umatilla County Surveyor
Date: 9/20/2013
Rec'd By: Doug Johnson
No.: 13-521-B