


**CERTIFIED RECORD OF LAND CORNER MONUMENTATION**

**HISTORY OF ORIGINAL CORNER ESTABLISHED:**

Corner originally established by Currin and Noland under GLO special contract dated May 4, 1887. Surveyor General field notes state:  
Set post, 48 X 4 X 4 ins., 24" in the ground for 47<sup>th</sup> mile post mkd. 47M on N. and UR on W. Faces, from which:  
A fir 10 ins. diam. bears S55°W 25 lks. dist. mkd. 47M UR BT  
Raised stone mound around it.

T 1 N R 35 E UIR M47

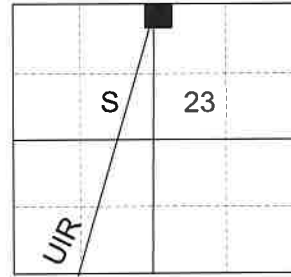

**DESCRIPTION OF CORNER EVIDENCE FOUND:**

None found.

**DESCRIPTION OF MONUMENT AND ACCESSORIES I ESTABLISHED TO MONUMENT THE ORIGINAL LOCATION OF THIS CORNER:**

At position by Survey I set a 5/8" x 30" iron pin, 28" in the ground, with 3" aluminum cap marked as shown below, from which:

**NEW BEARING OBJECTS:**

A 6" White Fir bears North 36° East, a dist. of 8.55 ft., marked M47 UIR BT.  
A 6" White Fir bears South 46° East, a dist. of 7.85 ft., marked M47 UIR BT.


Set steel fence post approx. 1 ft. South

I hereby certify that the corner was monumented on September 17, 2021.

Witness: Kyle A. Tucker, Emmitt Ambert



Renewal Date: June 30, 2023

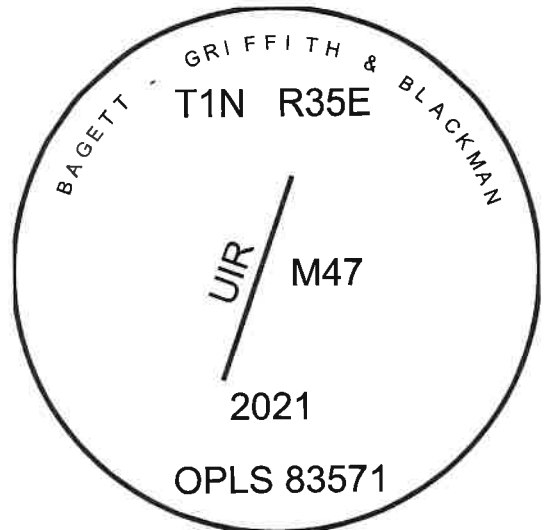

I used a steel tape and magnetic compass in the establishment of the new bearing tree accessories. I used 14° East declination. Distances are to a 60d spike driven into the right side of the root crown of the bearing trees. Bearings are to a brass washer marked OPLS 83571 is attached to the BT blaze of the new bearing trees.

**UIR-M47**

21-125-8