


CERTIFIED RECORD OF LAND CORNER MONUMENTATION

HISTORY OF ORIGINAL CORNER ESTABLISHED:

Corner not previously established.

T 1 N R 35 E O-20

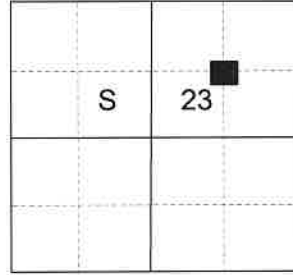

DESCRIPTION OF CORNER EVIDENCE FOUND:

None found.

Falls approx. 90 ft. Southwest of BLM approx. corner tag on fence post.

DESCRIPTION OF MONUMENT AND ACCESSORIES I ESTABLISHED TO MONUMENT THE ORIGINAL LOCATION OF THIS CORNER:

At position by Survey I set a 5/8" x 30" iron pin, 29" in the ground, with 2 1/2" aluminum cap marked as shown below, from which:

NEW BEARING OBJECTS:

A 12" Ponderosa Pine bears South 15° East, a dist. of 47.65 ft., marked NE 1/16 S23 BT.
An 11" Ponderosa Pine bears North 61° West, a dist. of 19.90 ft., marked NE 1/16 S23 BT.


Set steel fence post approx. 0.5 ft. West

I hereby certify that the corner was monumented on September 17, 2021.

Witness: Kyle A. Tucker, Emmitt Ambert



Renewal Date: June 30, 2023

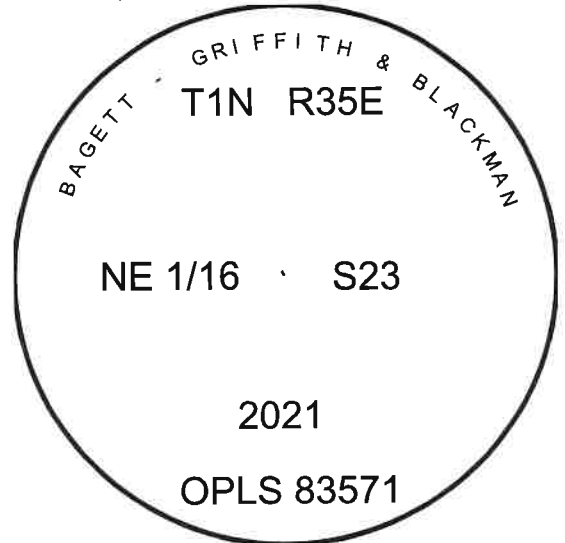

I used a steel tape and magnetic compass in the establishment of the new accessories. I used 14° East declination. Distances are to a 60d spike driven into the right side of the root crown of the bearing trees. Bearings are to a brass washer marked OPLS 83571 in the BT blaze of the new bearing tree