


CERTIFIED RECORD OF LAND CORNER MONUMENTATION

HISTORY OF ORIGINAL CORNER ESTABLISHED:

Corner not previously established.

T 1 N R 35 E P-19

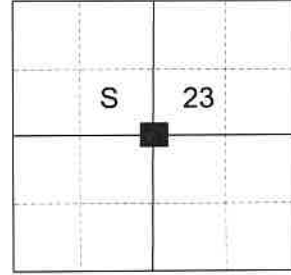

DESCRIPTION OF CORNER EVIDENCE FOUND:

None found.

DESCRIPTION OF MONUMENT AND ACCESSORIES I ESTABLISHED TO MONUMENT THE ORIGINAL LOCATION OF THIS CORNER:

At position by Survey I set a 5/8" x 30" iron pin, 28" in the ground, with 2 1/2" aluminum cap marked as shown below, in a collar of stone 2 ft., in diam., from which:


NEW BEARING OBJECTS:

A 12" Douglas Fir bears North 80° East, a dist. of 52.00 ft., marked C 1/4 S23 BT.
A 15" Douglas Fir bears South 10° East, a dist. of 19.05 ft., marked C 1/4 S23 BT.
A 7" Douglas Fir bears South 26° West, a dist. of 22.90 ft., marked C 1/4 S23 BT.
A 13" Douglas Fir bears North 60° West, a dist. of 30.75 ft., marked C 1/4 S23 BT, also has BLM approx. corner tag on Northwesterly side stating approx. corner is 30 ft. North of which the location falls in the middle of an old East/West running forest road.

Set steel fence post approx. 1 ft. West

I hereby certify that the corner was monumented on September 21, 2021.

Witnesses: Kyle Tucker, Emmitt Ambert

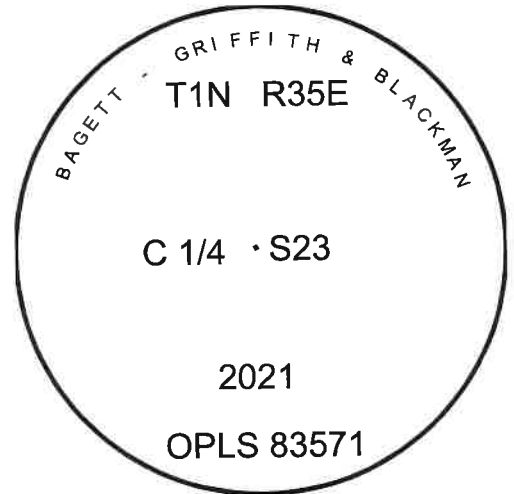

Renewal Date: June 30, 2023

I used a steel tape and magnetic compass in the establishment of the new accessories. I used 14° East declination. Distances are to a 60d spike driven into the right side of the root crown of the bearing trees. Bearings are to a brass washer marked OPLS 83571 is attached to the BT blaze of the new bearing trees.