


CERTIFIED RECORD OF LAND CORNER MONUMENTATION

HISTORY OF ORIGINAL CORNER ESTABLISHED:

Corner not previously established.

T 1 N R 35 E P-20

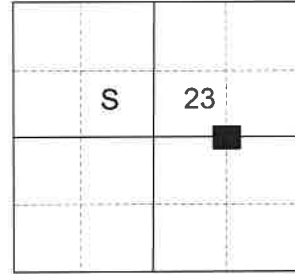

DESCRIPTION OF CORNER EVIDENCE FOUND:

None found.

DESCRIPTION OF MONUMENT AND ACCESSORIES I ESTABLISHED TO MONUMENT THE ORIGINAL LOCATION OF THIS CORNER:

At position determined by survey, I set a 5/8"x24" iron pin, 18" in the ground with a 2 1/2" aluminum cap, marked as shown below, in a collar of stone 3 ft. diam., from which:

NEW BEARING OBJECTS:

A 5/8" x 15" iron pin bears South 29°03' East, a dist. of 9.85 ft., with 1 1/2" aluminum cap marked SE RP.


A 5/8" x 15" iron pin bears South 64°51' West, a dist. of 9.01 ft., with 1 1/2" aluminum cap marked SW RP.

Set steel fence post approx. 1 ft. North

I hereby certify that the corner was monumented on September 15, 2021.
Witnesses: Kyle Tucker, Emmitt Ambert



Renewal Date: June 30, 2023

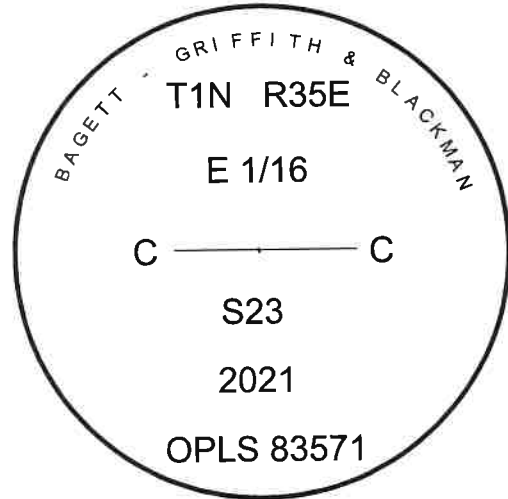

I used a Leica GS14 in the establishment of the accessories. Basis and bearing is as per survey for Hancock Forest Management, dated September 2021. Distances and bearings are to the center of the aluminum caps.