


**CERTIFIED RECORD OF LAND CORNER MONUMENTATION**

**HISTORY OF ORIGINAL CORNER ESTABLISHED:**

Corner originally established under contract No. 635, executed by Manius Buchanan dated April 19, 1895. Surveyor General record states:  
Set Fir post, 3 ft. long, 3 ins. square, 24" in the ground for 1/4 sec. cor. mkd. 1/4S on W. face from which:  
A pine 26 ins. diam. bears S61 1/2°E 81 lks. dist. mkd. 1/4 SBT  
A mound of stone 2 ft. base 1 1/2 ' high W. of cor., pits impracticable

T 1 N R 35 E P-21

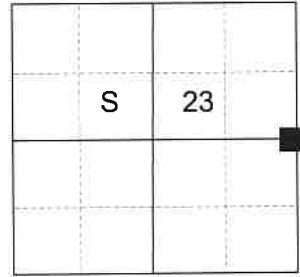

In 1991 Dennis Gaylord, PLS 1636, found a 5/8" iron rod protruding 8" above the ground with a steel fence post 1/2 ft. South. Pine stump with visible "BT" bears S61 1/2°E 81 lks.. Mound of stones bears West 3 ft.

**DESCRIPTION OF CORNER EVIDENCE FOUND:**

I found a 5/8" iron rod 6" above ground, from which:  
A 24" Ponderosa Pine stump bears South 61° East, a dist. of 54.00 ft., with "BT" scribes visible on badly decaying stump.  
A 3' diam. Mound of stone bears West approx. 3 ft.

Falls approx. 35 ft. South and 32 ft. West of fence corner remnant in North/South bearing fence line.

**DESCRIPTION OF MONUMENT AND ACCESSORIES I ESTABLISHED TO MONUMENT THE ORIGINAL LOCATION OF THIS CORNER:**

At found iron pin, I add a 2 1/2" aluminum cap marked as shown below and build a 3 ft. diam. collar of stone, from which:

**NEW BEARING OBJECTS:**

An 11" Ponderosa Pine bears North 60° East, a dist. of 25.70 ft., marked 1/4 S24 BT.  
A 17" Ponderosa Pine bears South 16° East, a dist. of 49.20 ft., marked 1/4 S24 BT.  
A 5/8" x 30" iron pin bears South 42°49' West, a dist. of 46.95 ft., with 1 1/2" aluminum cap marked SW RP.  
A 5/8" x 30" iron pin bears North 55°55' West, a dist. of 33.08 ft., with 1 1/2" aluminum cap marked NW RP.


Set steel fence post approx. 1 ft. North with BLM loc. tag

I hereby certify that the corner was monumented on September 15, 2021.

Witness: Kyle A. Tucker, Emmitt Ambert



Renewal Date: June 30, 2023

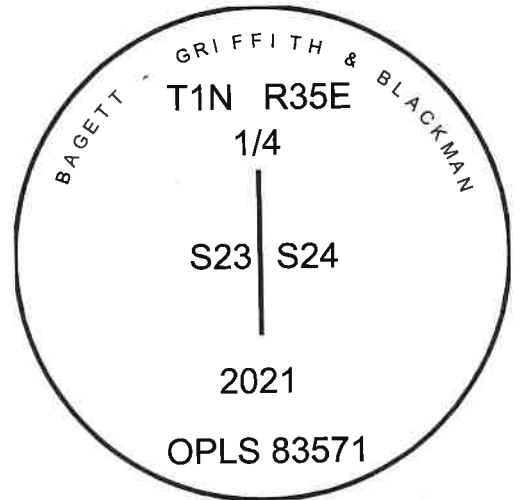

I used a steel tape and magnetic compass in the establishment of the new bearing tree accessories. I used 14° East declination. Distances are to a 60d spike driven into the right side of the root crown of the bearing trees. Bearings are to a brass washer marked OPLS 83571 is attached to the BT blaze of the new bearing trees. I used a Leica GS14 in the establishment of the iron pin accessories. Basis and bearing are as per survey for Hancock Forest Management dated September 2021. The distances and bearings are to the center of the aluminum caps.