


CERTIFIED RECORD OF LAND CORNER MONUMENTATION

HISTORY OF ORIGINAL CORNER ESTABLISHED:

Corner not previously established.

T 1 N R 35 E Q-21

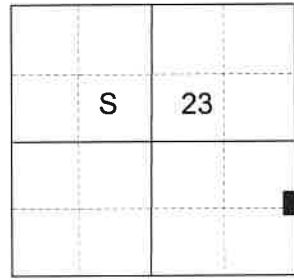

DESCRIPTION OF CORNER EVIDENCE FOUND:

None found.

Falls approx. 15 ft. West of North/South bearing fence line.

DESCRIPTION OF MONUMENT AND ACCESSORIES I

ESTABLISHED TO MONUMENT THE ORIGINAL LOCATION OF THIS CORNER:

At position by Survey I set a 5/8" x 30" iron pin, 28" in the ground, with 2 1/2" aluminum cap, marked as shown below, in a 2 ft. diam. collar of stone, from which:

NEW BEARING OBJECTS:

A 5" Ponderosa Pine bears North 20° East, a dist. of 11.25 ft., marked S 1/16 S24 BT.
A 7" Douglas Fir bears South 80° West, a dist. of 44.80 ft., marked S 1/16 S23 BT.


Set steel fence post approx. 1 ft. South

I hereby certify that the corner was monumented on September 15, 2021.

Witness: Kyle A. Tucker, Emmitt Ambert



Renewal Date: June 30, 2023

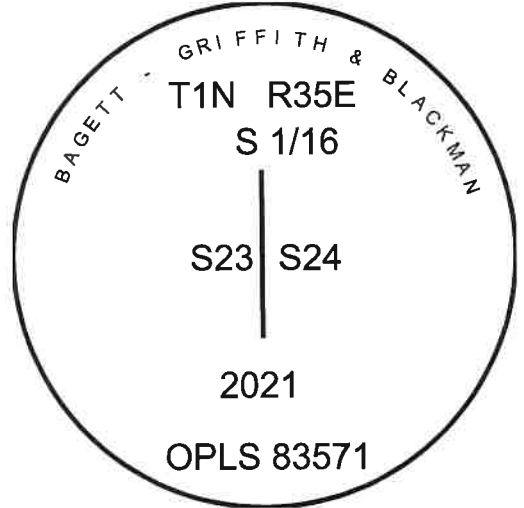

I used a steel tape and magnetic compass in the establishment of the new accessories. I used 14° East declination. Distances are to a 60d spike driven into the right side of the root crown of the bearing trees. Bearings are to a brass washer marked OPLS 83571 is attached to the BT blaze of the new bearing trees.

Q-21

21-125-8