


CERTIFIED RECORD OF LAND CORNER MONUMENTATION

HISTORY OF ORIGINAL CORNER ESTABLISHED:
Corner not previously established.

T 1 N R 35 E R-16

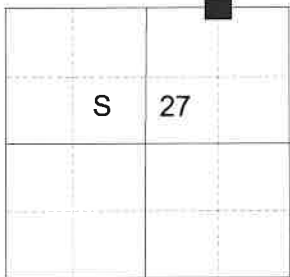

DESCRIPTION OF CORNER EVIDENCE FOUND:

None found. A fence post with approx. corner tag bears Southwesterly approx. 15 ft.

DESCRIPTION OF MONUMENT AND ACCESSORIES I ESTABLISHED TO MONUMENT THE ORIGINAL LOCATION OF THIS CORNER:

At position by survey I set a 5/8" x 30" iron pin, 28" in the ground, with 2 1/2" aluminum cap marked as shown below, from which:

NEW BEARING OBJECTS:

A 5" Ponderosa Pine bears South 42° East, a dist. of 18.60 feet, marked E 1/16 S27 BT.
A 5" Western Larch bears North 76° West, a dist. of 7.75 feet, marked NE 1/16 S22 BT.


Set steel fence post approx. 0.5 ft. West

I hereby certify that the corner was monumented November 4, 2025

Witness: Kyle Tucker, Nick Peckham



Renewal Date: June 30, 2027

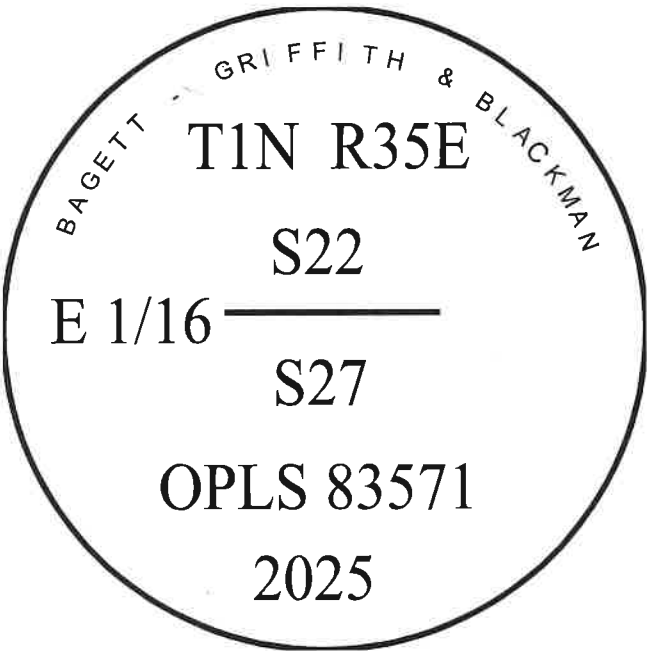

I use a tape and compass in the establishment of the new bearing trees. Bearings are measured from the center of the aluminum cap to a brass washer marked "OPLS 83571" tacked to the BT blaze using 14° East for declination. Distances are measured to from the center of the brass cap to a 60D spike in the center right base of the tree.