


**CERTIFIED RECORD OF LAND CORNER MONUMENTATION**

**HISTORY OF ORIGINAL CORNER ESTABLISHED:**  
Corner not previously established.


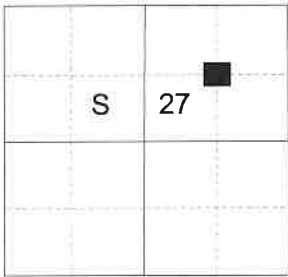

**DESCRIPTION OF CORNER EVIDENCE FOUND:**  
None found. A fence post with approx. corner tag bears Southwesterly approx. 15 ft.

**DESCRIPTION OF MONUMENT AND ACCESSORIES I ESTABLISHED TO MONUMENT THE ORIGINAL LOCATION OF THIS CORNER:**  
At position by survey I set a 5/8" x 30" iron pin, 25" in the ground, with 2 1/2" aluminum cap marked as shown below, from which:

**NEW BEARING OBJECTS:**  
An 11" Lodgepole Pine bears South 71° West, a dist. of 18.20 feet, marked NE 1/16 S27 BT.  
A 9" Douglas Fir bears North 18° West, a dist. of 12.45 feet, marked NE 1/16 S27 BT.


Set steel fence post approx. 0.3 ft. Southwest

I hereby certify that the corner was monumented November 4, 2025

Witness: Kyle Tucker, Nick Peckham



Renewal Date: June 30, 2027

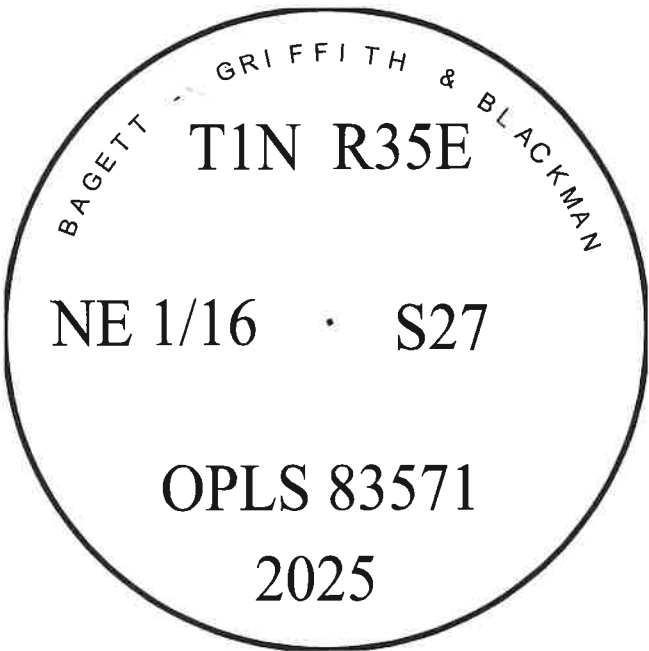

I use a tape and compass in the establishment of the new bearing trees. Bearings are measured from the center of the aluminum cap to a brass washer marked "OPLS 83571" tacked to the BT blaze using 14° East for declination. Distances are measured to from the center of the brass cap to a 60D spike in the center right base of the tree.