


CERTIFIED RECORD OF LAND CORNER MONUMENTATION

HISTORY OF ORIGINAL CORNER ESTABLISHED:

Corner originally established under GLO Special Contract dated May 4, 1887, executed by James P. Currin and James E. Noland. Surveyor General field notes state:

T 1 N R 35 E T-05

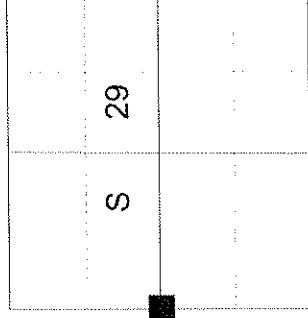

Set post 3 ft. long, 3 ins. square, 24 ins. in the ground for 1/4 S. cor marked 1/4 S on W. face, from which:

A red fir, 36 ins. diam., bears N45°W, 29 lks. dist marked 1/4 S. BT.
A pine 12 ins. diam., bears S69°E, 80 lks. dist. marked 1/4 S. BT.

Corner monumented from original corner evidence by Hollingwork in Survey S-124-B. Umatilla County Monumentation record states: Parks crew found 37" rotted red fir stump with "BT" visible, set corner record bearing and distance from this tree. Parks crew set: 5/8" capped iron rod marked "Oregon State Parks". 16" fir S82°E, 33.3' to center, scribed "W1/4 S29 BT" 12" fir N6°W, 24.5' to center, scribed "E1/4 S30 BT RS691".

DESCRIPTION OF CORNER EVIDENCE FOUND:

Found 5/8" iron pin with 1 1/4" aluminum cap marked "OREGON STATE PARKS", 4" above ground, from which:

A 16" fir stump bears South 82° East, a distance of 33.30 feet, with scribes visible.
A 16" Douglas fir bears North 6° West, a distance of 24.50 feet, alive and vigorous with healed blaze.

DESCRIPTION OF MONUMENT AND ACCESSORIES I ESTABLISHED TO PERPETUATE THE ORIGINAL LOCATION OF THIS CORNER:


From the iron pin monument,

NEW BEARING OBJECTS:

A 6" White fir bears North 49° East, a distance of 23.50 feet, marked 1/4 S29 BT.
A 7" White Fir bears South 46° East, a distance of 8.50 feet, marked 1/4 S29 BT.
A 7" White Fir bears South 2° West, a distance of 10.55 feet, marked 1/4 S30 BT.

I certify this corner was perpetuated October 5, 2018.

Witness: Kyle Tucker

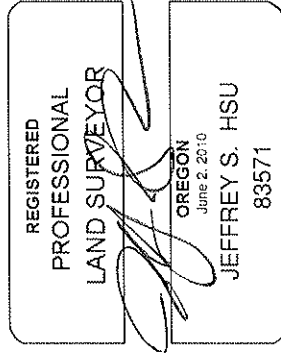

Renewal Date: June 30, 2019

I used a steel tape and magnetic compass in the establishment of the new accessories. I used 13° East declination. The distances are to a 60d spike driven into the side of the root crown of the bearing trees. A brass washer marked OPLS 83571 is attached to the BT blaze of the new bearing trees.

T-05

18-106-12