


CERTIFIED RECORD OF LAND CORNER MONUMENTATION

HISTORY OF ORIGINAL CORNER ESTABLISHED:

Corner originally established under GLO contract No. 635, executed by Manius Buchanan dated April 19, 1895. Surveyor General field notes state:
Set post 3 ft. long, 3 ins. square, 24" in the ground, for 1/4 sec. cor. mkd. 1/4S on W. face from which:
A fir 22 ins. diam. bears N72 1/2°W 14 lks dist. mkd. 1/4 SBT
A fir 10 ins. diam. bears S41°E 27 lks dist. mkd. 1/4 SBT

T 1 N R 35 E T-21

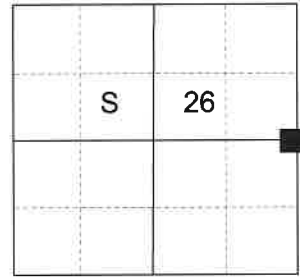

DESCRIPTION OF CORNER EVIDENCE FOUND:

None found.

Falls approx. 35 ft. South and 32 ft. West of fence corner remnant in North/South bearing fence line.

DESCRIPTION OF MONUMENT AND ACCESSORIES I

ESTABLISHED TO MONUMENT THE ORIGINAL LOCATION OF THIS CORNER:

At position by Survey I set a 2 1/2" x 30" aluminum pipe, 25" in the ground, with 3" aluminum cap marked below, in a collar of stone 2 ft. in diam., from which:

NEW BEARING OBJECTS:

- A 5" White Fir bears North 64° East, a dist. of 4.75 ft., marked 1/4 S25 BT.
- A 4" Lodgepole Pine bears South 26° East, a dist. of 4.50 ft., marked 1/4 S25 BT.
- A 5" Douglas Fir bears South 42° West, a dist. of 5.75 ft., marked 1/4 S26 BT.
- An 8" White Fir bears North 18° West, a dist. of 8.85 ft., marked 1/4 S26 BT.


Set steel fence post approx. 1 ft. North

I hereby certify that the corner was monumented on September 15, 2021.

Witness: Kyle A. Tucker, Emmitt Ambert



Renewal Date: June 30, 2023

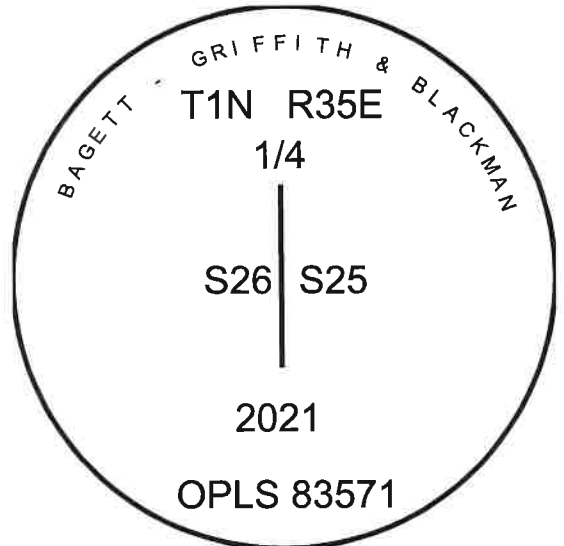

I used a steel tape and magnetic compass in the establishment of the new accessories. I used 14° East declination. Distances are to a 60d spike driven into the right side of the root crown of the bearing trees. Bearings are to a brass washer marked OPLS 83571 is attached to the BT blaze of the new bearing trees.

T-21

21-125-8