

CERTIFIED RECORD OF LAND CORNER MONUMENTATION

**HISTORY OF ORIGINAL CORNER ESTABLISHED:**

Corner not previously established.

T 1 N R 35 E U-15

S	27
	■

**DESCRIPTION OF CORNER EVIDENCE FOUND:**

Boise Cascade location tag on fence post, lying on the ground, bears approx. 20 ft. South West.

**DESCRIPTION OF MONUMENT AND ACCESSORIES I ESTABLISHED TO PERPETUATE THE**

**ORIGINAL LOCATION OF THIS CORNER:**

At position determined by survey, I set a 5/8" x 15" iron pin with 2 1/2" aluminum cap, marked as shown below, drilled 12" into rock, with 2 ft. diam. collar of stone, from which:


**NEW BEARING TREES:**

A 13" Lodgepole pine bears South 14° East a dist. of 29.40 ft. marked CS 1/16 S27 BT.  
A 7" Lodgepole pine bears North 65° West a dist. of 23.80 ft. marked CS 1/16 S27 BT.


Set a steel fence post approx. 1 foot North of the corner monument.

I hereby certify that the corner was perpetuated on June 27, 2018.

Witness: Kyle Tucker, Ryan Skeen

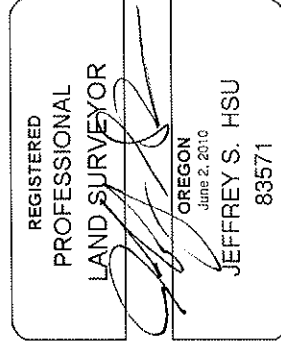

Renewal Date: June 30, 2019

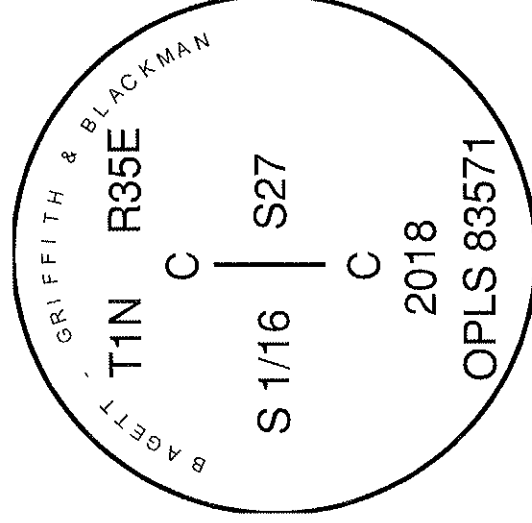

I used a steel tape and magnetic compass in the establishment of the new accessories. I used 13° East declination, the distances are to a 60d spike driven into the right side of the root crown of the bearing trees. A brass washer marked OPLS 83571 is attached to the BT blaze of the new bearing trees.

*18-056-B*

U-15