


CERTIFIED RECORD OF LAND CORNER MONUMENTATION

HISTORY OF ORIGINAL CORNER ESTABLISHED:

Corner was originally established by Gary Wagner in Umatilla County Survey 05-181-B. Survey record states:

Set 5/8" x 30" rebar with yellow plastic cap stamped "Wagner 02817LS"

T 1 N R 35 E V-16

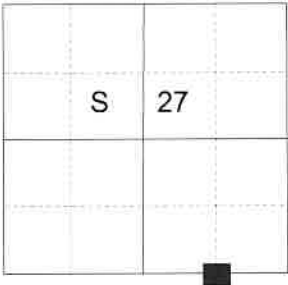

DESCRIPTION OF CORNER EVIDENCE FOUND:

Found a 5/8" iron pin with 1 1/2" yellow plastic cap marked as shown, 3" above ground. A yellow carsonite post marked SURVEY MARKER bears approx. 0.5 feet Northeasterly, steel fence post bears approx. 0.5 feet West.

DESCRIPTION OF MONUMENT AND ACCESSORIES I ESTABLISHED TO PERPETUATE THE ORIGINAL LOCATION OF THIS CORNER:


From the iron pin monument:

NEW BEARING OBJECTS:

A 5" Douglas Fir bears North 37° East, a dist. of 6.30 feet, marked E 1/16 S27 BT.
An 11" Douglas Fir bears South 28° East, a dist. of 12.60 feet, marked E 1/16 S34 BT.

I hereby certify that the corner was perpetuated November 11, 2025

Witness: Kyle Tucker, Nick Peckham

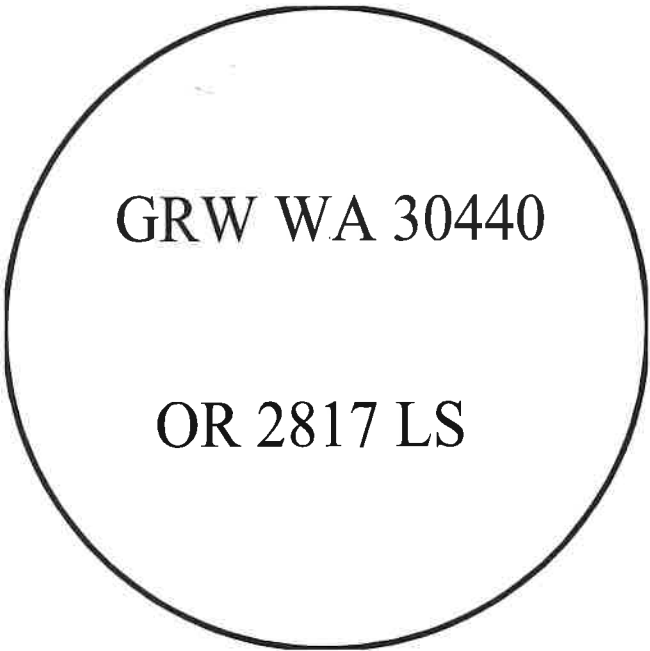

Renewal Date: June 30, 2027

I use a tape and compass in the establishment of the new bearing trees. Bearings are measured from the center of the aluminum cap to a brass washer marked "OPLS 83571" tacked to the BT blaze using 14° East for declination. Distances are measured to from the center of the brass cap to a 60D spike in the center right base of the tree.