

U. S. Department of Agriculture
FOREST SERVICE

Wona NATIONAL FOREST
CORNERS OF THE PUBLIC SURVEY



T. 1N R. 35 E Mer.

Section Corner common to Sections
34, 36, 35, and 36

Corner consists of a mound of stones (not) in place
State condition scattered

Dimensions above ground _____ inches.

Sketch grooves, letters, figures, or notches, on proper face or edge.

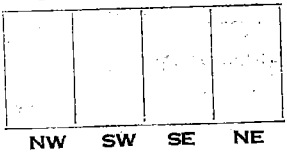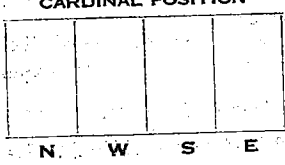

Mound of _____ is located _____

Pits are located _____

Sketch markings of Bearing Trees (or Rocks) in proper box and fill blanks below, giving bearings from Corner to Trees and Distances in Links.

TIN
R35E

TIN
R35E
525

Species DB stump PP stump

Diameter 22" 20"

Bearing NW E

Distance 25% 40%

Do you believe this to be a genuine Land Office Corner? Yes

If not, why? _____


Stumps are rotted. Original
recording in danger of being
lost.

7/15/54
(Date)

DFR
(Signature)
(Title)

T. _____ R. _____ Mer. _____

(Make sketch of topography near Corner and show section line markers thus "X")

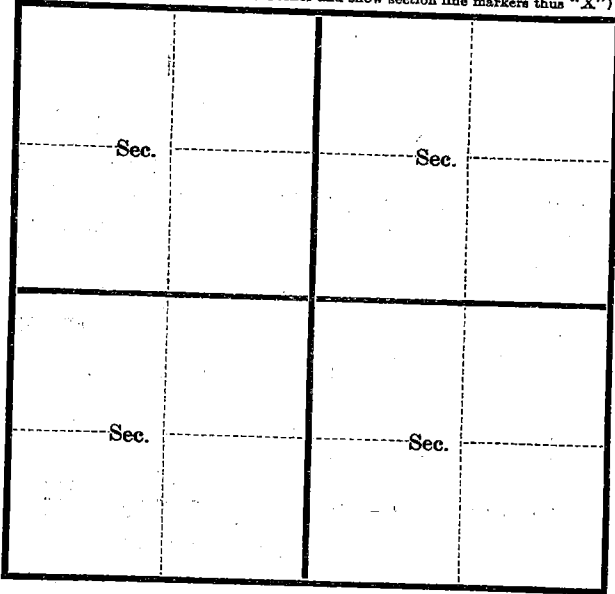

Metal Location Poster is on a pp _____

tree 10 inches diameter, on the _____

side of _____ from which

this Corner bears _____ Chains.

(Bearing) (Distance)

Section line marker between Secs. _____ and _____ is on

a _____ on the _____

(Tree, post, etc.) (Name of road, trail, etc.)

located _____ chains E, W, N, S., from Sec. Cor.; 1/4 Cor.; Witness Cor.

(Cross out nonapplicable)

Give any further facts needed to find Corner again:

*Top corner of the
Sutton ranch near
of Chick Rock, Ill. Co.,*