


CERTIFIED RECORD OF LAND CORNER MONUMENTATION

**HISTORY OF ORIGINAL CORNER ESTABLISHED:**

None.

T 1 N R 35 E W-09

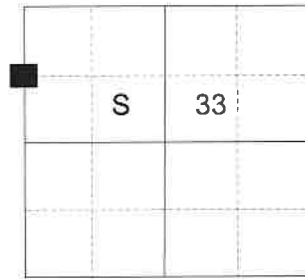

**DESCRIPTION OF CORNER EVIDENCE FOUND:**

A 30+\" White Fir with 1954 Loc. tag bears approx. 14 ft. North Easterly.

A North South fence line bears approx. 19' East.

**DESCRIPTION OF MONUMENT AND ACCESSORIES I ESTABLISHED TO MONUMENT THE LOCATION OF THIS CORNER:**

At position determined by survey I set a 5/8\" x 30\" iron pin, 28\" in the ground, with 2 1/2\" aluminum cap marked as shown below, from which:

**NEW BEARING OBJECTS:**

A 6\" White Fir bears South 42° East a dist. of 4.45 ft., marked N 1/16 S33 BT.

A 5\" Lodgepole Pine bears South 28° West a dist. of 7.95 ft., marked N 1/16 S32 BT.


Set steel fence post approx. 1 ft. North

I hereby certify that the corner was monumented on September 10, 2019.

Witness: Kyle A. Tucker



Renewal Date: June 30, 2021

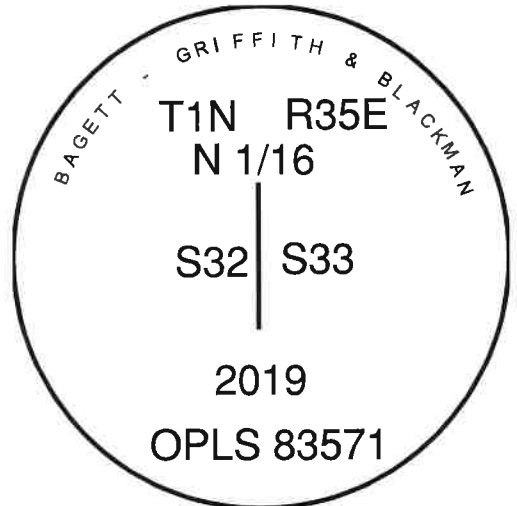

I used a steel tape and magnetic compass in the establishment of the new accessories. I used 13° East declination, the distances are to a 60d spike driven into the right side of the root crown of the bearing trees. A brass washer marked OPLS 83571 is attached to the BT blaze of the new bearing trees.