

Index

File No. Z-23

CORNER RECORD (SEARCH)

(Ref. FSM 7151.4)

Tract or

Survey No. _____

Cor.

No. _____

T 2N R. 36E

R.D. Walla Walla


County Umatilla

Merid. Willamette

N.F. Umatilla

State Oregon

CORNER DIAGRAM Sec. 36

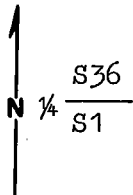

DESCRIBE CORNER MONUMENT FOUND

Basalt stone 12x10x6 (record 14x10x8) lying loose on ground-
no marks identifiable.

DESCRIBE BEARING TREES OR OTHER OFFICIAL ACCESSORIES FOUND

Orig. 36" now down and rotted Pine stump with axe marks N36E-
84 ft. (record 188 lks.-possibly should have been 128 lks.).
48" Pine East 80 ft. with line blazes East and West-West blaze
previously opened to verify date-fits creek call West very well.

PHOTO IDENTIFICATION DATA

Photo No. 1280-50

Filed At. Umatilla N.F.

Object Ident. two I.P.'s

Ident. By L. Wisang
Signature

PLANE COORDINATE POSITION DATA

State _____ Zone _____

X _____

Y _____

Estob. By _____
Agency

DESCRIBE CORNER LOCATION RELATIVE TO NEAR-BY FEATURES, ALSO HOW TO REACH CORNER

From the signed wood post where the East line of Section 36
crosses Rd.#3128 go West on Rd.#3128 approx 0.4 mile to Jeep
road South. Follow Jeep road to point of ridge and posted line-
corner is West 400 ft. to 600 ft..

Signature
Larry D. Wisang

Title
Land Surveyor

Division _____

Headquarters _____

Date 6/83 7100-52-(3.68)

CORNER RECORD (PERPETUATION)

MONUMENT: DESCRIBE NEW MONUMENT SET, OR WORK DONE TO PRESERVE EXISTING MONUMENT

Set 2½" x 30" Aluminum pipe with a 2½" Aluminum cap 10" in ground-built mound of stone 4 ft. base 20" high.

ACCESSORIES: DESCRIBE NEW BT'S WITNESS OBJECTS ETC. ESTABLISHED, OR WORK DONE TO PRESERVE EXISTING EVIDENCE

13" P. Pine N47¼E-88.8 ft. scribed ¼S36BT and with a 1" Brass disk stamped PLS 896.

4" Pine S42¼E-143.2 ft. nailed BT sign only-no blaze.

Work Done By Larry D. Bishop Title Surveyor Date 6/83 State Registration No. 896
or Agency

Certified Cor. Record Prepared? Yes No Filed At: _____ Date _____

REMARKS

Nailed 54-4 and BT signs to BT's and painted band and blazes red.
Set guard post East with signs 54-2 and 54-4.

Index File No. Z-23

T 2N R. 36E

Merid. Will

CORNER RECORD (SEARCH)

(Ref. FSM 7151.4)


Tract or Survey No. _____

Cor. No. _____

R.D. WALLA WALLA County UMATILLA

N.F. UMATILLA State OREGON

CORNER DIAGRAM

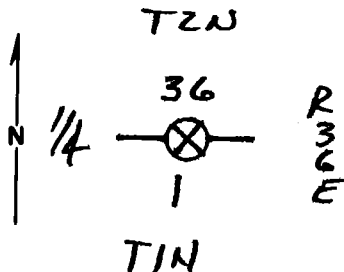

DESCRIBE CORNER MONUMENT FOUND

STONE LYING LOOSE ON GROUND - IS A BIT SMALLER THAN RECORD SIZE - NO MARKS VISIBLE.

DESCRIBE BEARING TREES OR OTHER OFFICIAL ACCESSORIES FOUND

ORIG. 36" PINE B.T. IS DOWN & BADLY DECAYED. NO MARKS OR SCRIBES REMAIN. BEARS N360E, 91'-FT. A 48" PINE BEARS EAST 80'± & HAS ORIGINAL LINE BLAZES ON EAST & WEST SIDES. BLAZE ON WEST SIDE HAS BEEN

DESCRIBE CORNER LOCATION RELATIVE TO NEAR-BY FEATURES, ALSO HOW TO REACH CORNER

PREVIOUSLY CHOPPED OPEN. CREEK CALL TO WEST FITS PERFECTLY. (389 FT WEST)

PHOTO IDENTIFICATION DATA

Photo No. _____
 Filed At. _____
 Object Ident. _____
 Ident. By _____
 Signature _____

PLANE COORDINATE POSITION DATA

State _____ Zone _____
 X _____
 Y _____
 Estab. By _____
 Agency _____

Signature Dennis J. Hayford Title _____ Division PLS Headquarters 1636 Date 7-8-82 7100-52 (3. 68)

CORNER RECORD (PERPETUATION)

MONUMENT : DESCRIBE NEW MONUMENT SET, OR WORK DONE TO PRESERVE EXISTING MONUMENT

ACCESSORIES : DESCRIBE NEW BT'S WITNESS OBJECTS ETC. ESTABLISHED, OR WORK DONE TO PRESERVE EXISTING EVIDENCE

Work Done By _____ **Title** _____ **Date** _____ **State Registration No.**
or Agency _____ 10

Certified Cor. Record Prepared ? Yes No **Filed At:** _____ **Date** _____ 11

REMARKS

Index File No. **T.** **R.** **M.** **Tract or Surv. No.** **Cor.** 12
13