

Index File No. T-2

CORNER RECORD (SEARCH)


(Ref. FSM 7151.4)

Tract or Survey No. _____ Cor. No. _____

T IN. R. 37 E.
Merid. W.M.

R.D. Walla Walla County Umatilla
N.F. Umatilla State OR

CORNER DIAGRAM

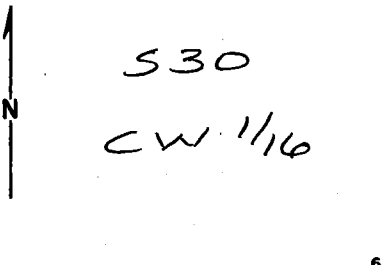

DESCRIBE CORNER MONUMENT FOUND

None

DESCRIBE BEARING TREES OR OTHER OFFICIAL ACCESSORIES FOUND

None

PHOTO IDENTIFICATION DATA

Photo No. _____
Filed At. _____
Object Ident. _____
Ident. By _____
Signature

DESCRIBE CORNER LOCATION RELATIVE TO NEAR-BY FEATURES, ALSO HOW TO REACH CORNER

SOUTH OF CREEK ON STEEP NORTH SLOPE. SOUTH OF HOSKINS CABIN

PLANE COORDINATE POSITION DATA

State _____ Zone _____
X _____
Y _____
Estab. By _____
Agency

Signature Muhand P. Zogaj Title P.L.S. Division _____ Headquarters _____ Date 10/93 FS-7100-52 (3/68)

CORNER RECORD (PERPETUATION)

MONUMENT: DESCRIBE NEW MONUMENT SET, OR WORK DONE TO PRESERVE EXISTING MONUMENT

At a section subdivision as determined by this survey set a 3 1/4" aluminum cap on a 2 1/2" x 30" aluminum pipe, 24" in the ground.

TIN R 37E
CW 1/16
S30
PLS 2535
1993

ACCESSORIES: DESCRIBE NEW BT'S WITNESS OBJECTS ETC. ESTABLISHED, OR WORK DONE TO PRESERVE EXISTING EVIDENCE

10" Douglas fir bears N. 47 1/2° E., 46.2 feet scribed CW 1/16 S30 BT

8" Douglas fir bears S. 85° E., 64.5 feet scribed CW 1/16 S30 BT

Work Done By LeJeune Title P.L.S. Date 9/93 State Registration No. or Agency 2535

Certified Cor. Record Prepared Yes No Filed At: _____ Date _____

REMARKS