

USDA-FOREST SERVICE

Index File No. X-25

CORNER RECORD (SEARCH)

(Ref. FSM 7151.4)

Tract or Survey No. _____ Cor. No. _____


T 1N R. 37E

R.D. WALLA WALLA County UMATILLA-UNION CO. LINE

Merid. WILL.

N.F. UMATILLA State OREGON

CORNER DIAGRAM

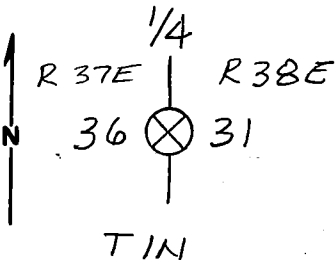

DESCRIBE CORNER MONUMENT FOUND

SMALL M.D.S. AT CORNER

DESCRIBE BEARING TREES OR OTHER OFFICIAL ACCESSORIES FOUND

ORIG. 16" FIR IS NOW AN 18" DOUG. FIR SNAG 6' HIGH WITH PARTLY HEALED DOUBLE BLAZES WITH SCRIBING, "1/4 S BT", VISIBLE. BEARS S 80°E, 21.1ft.

PHOTO IDENTIFICATION DATA

Photo No. _____
Filed At. _____
Object Ident. _____
Ident. By _____
Signature

DESCRIBE CORNER LOCATION RELATIVE TO NEAR-BY FEATURES, ALSO HOW TO REACH CORNER

CORNER IS VISIBLE FROM SUMMIT ROAD 31

PLANE COORDINATE POSITION DATA

State _____ Zone _____
X _____
Y _____
Estab. By _____
Agency

Signature

Title

Division

Headquarters

Date

7100-52-(3.68)

Dennis L. Gaylord PLS

1636

9/30/81

CORNER RECORD (PERPETUATION)

MONUMENT: DESCRIBE NEW MONUMENT SET, OR WORK DONE TO PRESERVE EXISTING MONUMENT

ACCESSORIES : DESCRIBE NEW BT'S WITNESS OBJECTS ETC. ESTABLISHED, OR WORK DONE TO PRESERVE EXISTING EVIDENCE

Work Done By _____ Title _____ Date _____ State Registration No. _____
or Agency _____
Certified Cor. Record Prepared ? Yes No Filed At: _____ Date _____

REMARKS

Index File No. T. R. M. Tract or Surv. No. Cor.

Index
File No. X-25 (X-1)


CORNER RECORD (SEARCH)
(Ref. FSM 7151.4)

Tract or _____ Cor. No. _____
Survey No. _____

T 1 N R. 37E(38E) R.D. WALLA WALLA County UMATILLA-UNION Co. Line

Merid. Willamette N.F. UMATILLA State OREGON

CORNER DIAGRAM

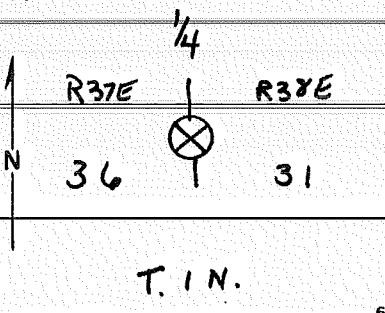

DESCRIBE CORNER MONUMENT FOUND

Small mound of stone at corner.

DESCRIBE BEARING TREES OR OTHER OFFICIAL ACCESSORIES FOUND

Orig. 16" fir is now an 18" of snag 6' high w/ partly
ruled double blazes w/ scribing "1/4 S BT, visible.
Brs. S8°E, 21.1 ft.

PHOTO IDENTIFICATION DATA

Photo No. _____
Filed At. _____
Object Ident. _____
Ident. By _____
Signature

DESCRIBE CORNER LOCATION RELATIVE TO NEAR-BY FEATURES, ALSO HOW TO REACH CORNER

Corner is visible from Summit Rd # 31.

PLANE COORDINATE POSITION DATA

State _____ Zone _____
X _____
Y _____
Estab. By _____
Agency

Signature
Dennis L. Gaylord

Title
PLS 1636

Division
Umatilla NF

Date
9/30/81