

Index
File No. Z-05


CORNER RECORD (SEARCH)

(Ref. FSM 7151.4)

Tract or
Survey No. _____ Cor.
No. _____

T 1N R. 37E R.D. WALLA WALLA County UMATILLA
Merid. WILLAMETTE N.F. UMATILLA State OREGON

CORNER DIAGRAM

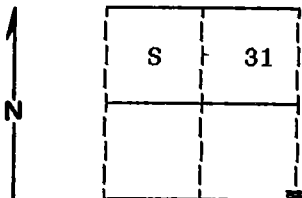

DESCRIBE CORNER MONUMENT FOUND

Found no evidence of the original corner monument

DESCRIBE BEARING TREES OR OTHER OFFICIAL ACCESSORIES FOUND

Found the rotted remains of a stump previously believed to be the bearing tree. The remains are definitely those of a Fir. The original notes call for a Pine. I am unable to accept this evidence for monumentation.

PHOTO IDENTIFICATION DATA

Photo No. _____
Filed At. _____
Object Ident. _____
Ident. By _____
Signature

DESCRIBE CORNER LOCATION RELATIVE TO NEAR-BY FEATURES, ALSO HOW TO REACH CORNER

Corner falls on steep timbered East slope approximately 100 feet West of Bear Creek and Bear Creek Trail number 3087.

PLANE COORDINATE POSITION DATA

State _____ Zone _____
X _____
Y _____
Estab. By _____

Signature
Agency

Title _____ Division _____ Headquarters _____

Date 9-19-89 FS-7100-52 (3/68)

CORNER RECORD (PERPETUATION)

MONUMENT: DESCRIBE NEW MONUMENT SET, OR WORK DONE TO PRESERVE EXISTING MONUMENT

Did not monument corner due to the lack of original evidence.

ACCESSORIES : DESCRIBE NEW BT's WITNESS OBJECTS ETC. ESTABLISHED, OR WORK DONE TO PRESERVE EXISTING EVIDENCE

None

Work Done By D.I. Griffith Title Surveyor Date 9-5-89 State Registration No. OPLS 644
or Agency

Certified Cor. Record Prepared ? Yes No Filed At: _____ Date _____

REMARKS

Index File No. Z-05 T. 1N R. 37E W.M. Tract or Surv. No. _____ Cor. _____

Index File No. Z-5

CORNER RECORD (SEARCH)

(Ref. FSM 7151.4)

Tract or Survey No. _____ Cor. No. _____


T IN R. 37E

R.D. WALLA WALLA County UMATILLA

Merid. WILL

N.F. UMATILLA State OREGON

CORNER DIAGRAM

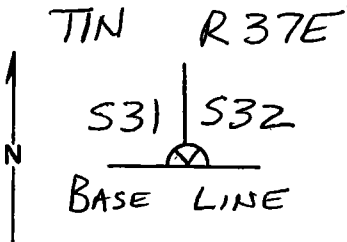

DESCRIBE CORNER MONUMENT FOUND

NONE

DESCRIBE BEARING TREES OR OTHER OFFICIAL ACCESSORIES FOUND

DECAYED PINE STUMP - NO VISIBLE MARKS - BEARS S5°E, 30.4 ft, ON SIDE HILL.

DECAYED FIR STUMP - NO VISIBLE MARKS - BEARS N80°E, 33.0 ft, IN CREEK BOTTOM.

DECAYED FIR STUMP - NO VISIBLE MARKS - BEARS N20°W, 47.5 ft, ON SIDE HILL.

DESCRIBE CORNER LOCATION RELATIVE TO NEAR-BY FEATURES, ALSO HOW TO REACH CORNER FOUND CORNER BY CHAINING WEST 660 ft, FROM S6 1/2 E.

TOPOG CALLS OF RECORD TO EAST OF THIS CORNER FIT VERY WELL. THE DECAYED PINE STUMP IS 20-25 FEET NORTH OF A 24" PINE WHICH HAS BEEN OPENED WITH A CHAINSAW. I PUT LOCATION POSTER ON 14" FIR 100 FT. EAST OF CORNER TO EAST OF TRAIL NO. 3087

PHOTO IDENTIFICATION DATA

Photo No. _____
 Filed At. _____
 Object Ident. _____
 Ident. By _____

Signature

PLANE COORDINATE POSITION DATA

State _____ Zone _____
 X _____
 Y _____
 Estab. By _____

Agency

Signature

Title

Division

Headquarters

Date

FS-7100-52 (3/68)

Demmer J. Layford

LS 1636

5-12-88

CORNER RECORD (PERPETUATION)

MONUMENT : DESCRIBE NEW MONUMENT SET, OR WORK DONE TO PRESERVE EXISTING MONUMENT

9

ACCESSORIES : DESCRIBE NEW BT's WITNESS OBJECTS ETC. ESTABLISHED, OR WORK DONE TO PRESERVE EXISTING EVIDENCE

10

Work Done By _____ Title _____ Date _____ State Registration No. or Agency _____

Certified Cor. Record Prepared ? Yes No Filed At: _____ Date _____

11

REMARKS

12

Index File No. T. R. M. Tract or Surv. No. Cor. 13