

Index

File No. G-1

**CORNER RECORD (SEARCH)**

(Ref. FSM 7151.4)

T 1N R. 38E


R.D. Walla Walla County Union

Tract or Survey No. \_\_\_\_\_ Cor. No. \_\_\_\_\_

Merid. Willamette

N.F. Umatilla State Oregon

**CORNER DIAGRAM**

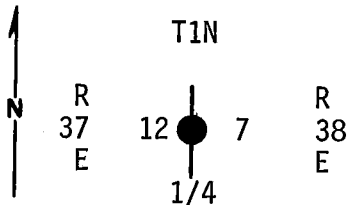

**DESCRIBE CORNER MONUMENT FOUND**

None.

**DESCRIBE BEARING TREES OR OTHER OFFICIAL ACCESSORIES FOUND**

No trace of the original corner post or bearing trees could be found. We do find a well-defined line of blazes running N-S, and open one North of the corner point, which is 95-100 years old by ring count.

**PHOTO IDENTIFICATION DATA**

Photo No. \_\_\_\_\_

Filed At. \_\_\_\_\_

Object Ident. \_\_\_\_\_

Ident. By \_\_\_\_\_

*Signature*

**PLANE COORDINATE POSITION DATA**

State \_\_\_\_\_ Zone \_\_\_\_\_

X \_\_\_\_\_

Y \_\_\_\_\_

Estab. By \_\_\_\_\_

*Agency*

*Mary A. Douglas*  
Signature

Title  
Land Surveyor

Division  
PLS 1099

Headquarters

Date  
9/29/80

7100-52 (3. 68)

**CORNER RECORD (PERPETUATION)**

**MONUMENT: DESCRIBE NEW MONUMENT SET, OR WORK DONE TO PRESERVE EXISTING MONUMENT**

We therefore establish the True Corner Point as follows:

At 2.75 chains south of a well-defined spring branch, Course E, on a steep N. hillside and at a mean E-W position along the found line of N-S blazes, we set a 2"x30" Galvanized Iron Pipe, 28" in the ground with brass cap attached, marked:

	T1N		
R	S12		S7
37			38
			1/4
E	PLS 1099		E
			1980

**ACCESSORIES: DESCRIBE NEW BT'S WITNESS OBJECTS ETC. ESTABLISHED, OR WORK DONE TO PRESERVE EXISTING EVIDENCE**

From which we mark new Bearing Trees: A 16" Grand Fir, scribed "1/4 S12 BT" on a double blaze bears N74°W 29.8 ft., And a 22" Spruce, scribed "1/4 S7 BT" on a double blaze bears S10°E 15.5 ft. Attached brass washer stamped "LS 1099" to lower blaze of new BTs. Placed steel fence post 5 ft. south of monument with sign 54-4 attached. Attached signs and painted BTs per "Standard Specifications for Cadastral Survey," U.S.F.S. Region 6 October, 1979.

Work Done By. Gary Langlitz Title Land Surveyor Date 9/29/80 State Registration No. PLS 1099  
or Agency

Certified Cor. Record Prepared? Yes  No  Filed At: Union County Surveyor Date December 1980

**REMARKS**

Compass Declination: 20° East

Witness: John Curtiss