

USDA-FOREST SERVICE

Index _____

File No. H-3

T 1N R. 38E

Merid. Willamette

CORNER RECORD (SEARCH)


(Ref. FSM 7151.4)

R.D. Walla Walla County Union

N.F. Umatilla State Oregon

Tract or Survey No. _____ Cor. No. _____

CORNER DIAGRAM

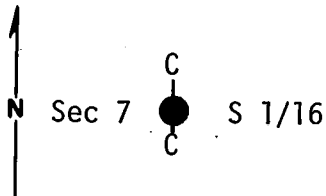

DESCRIBE CORNER MONUMENT FOUND

None

DESCRIBE BEARING TREES OR OTHER OFFICIAL ACCESSORIES FOUND

None.

PHOTO IDENTIFICATION DATA

Photo No. _____

Filed At. _____

Object Ident. _____

Ident. By _____

Signature

PLANE COORDINATE POSITION DATA

State _____ Zone _____

X _____

Y _____

Estab. By _____

Agency

DESCRIBE CORNER LOCATION RELATIVE TO NEAR-BY FEATURES, ALSO HOW TO REACH CORNER

Corner is located approx. 100' West of a graveled road, U.S.F.S. road No. 3200160.

Signature
Larry J. Langley

Title
Land Surveyor

Division
PLS 1099

Headquarters

Date
10-10-80

7100-52 (3. 68)

CORNER RECORD (PERPETUATION)

MONUMENT: DESCRIBE NEW MONUMENT SET, OR WORK DONE TO PRESERVE EXISTING MONUMENT

T1N R38E
 C
 S7 | S 1/16
 C
 PLS 1099
 1980

Corner set from survey at location determined by subdivision of section.
 At the corner point, we set a 2"x30" galvanized iron pipe, 28" in the ground with brass cap attached, marked:

ACCESSORIES : DESCRIBE NEW BT'S WITNESS OBJECTS ETC. ESTABLISHED, OR WORK DONE TO PRESERVE EXISTING EVIDENCE

From which we mark new BT's:

A 14" White Fir, scribed "CS 1/16 S7 BT" on a double blaze bears N71°E 41.0 ft.,
 A 16" Spruce, scribed "CS 1/16 S7 BT" on a double blaze bears N19°W 25.6 ft. Attached brass washer, marked "LS 1099" to lower blaze of each BT. Placed steel fenceposts 5' E of monument with signs 54-2 and 54-9 attached. Attached signs and painted BT's per Standard Specifications for Cadastral Survey, U.S.F.S. Region 6, October 1979.

Work Done By: Gary Langlitz Title Land Surveyor Date 10-10-80 State Registration No. PLS 1099
 or Agency

Certified Cor. Record Prepared? Yes No Filed At: Union County Surveyor Date Dec. 1980

REMARKS

Compass Declination: 18° East
 Witness: John Curtiss