


CERTIFIED RECORD OF LAND CORNER MONUMENTATION

A - 1
DIAGRAM

History of original corner establishment:

The original corner was established by George S. Pershin, deputy, (compassman) on September 11, 1871, under joint GLO contract No. 154, as follows:

Set a stone, 30" x 7" x 6", for the corner to Township 1 S., Ranges 29 and 30 East, at intersection of base line 6 chains and 57 links west of the mound, the corner to sections 35 and 36, Township 1 N., Range 29 E. Raised a mound of stones per instructions.

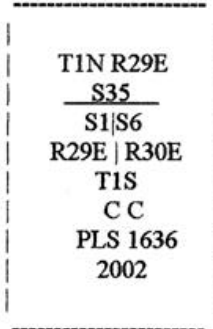

Original corner evidence recovered:

Found the original corner stone loosely set on the west edge of a mound of stones. The corner stone is 26" x 8" x 7" and is plainly marked with six notches on the east, west and south edges and "CC" on the southwest face.

Monument and accessories established to perpetuate the original position of this corner:

In place of the original corner stone, I set a 1" x 18" flared, galvanized iron pipe 10" into the ground. A 2 1/2" brass cap attached to the top of the pipe is marked as shown in the diagram above. I bury the corner stone along the east side of the pipe and build a mound of stones around the pipe, from which:

A 5/8" x 24" iron rod set 23" into the ground with a 3/4" brass washer, marked "PLS 1636 NE", attached at ground level, bears N61° 15' E, 141.0 feet.

A 5/8" x 24" iron rod set 22" into the ground with a 3/4" brass washer, marked "PLS 1636 S6", attached at ground level, bears S43° E, 99.3 feet.


A 5/8" x 24" iron rod set 23" into the ground with a 3/4" brass washer, marked "PLS 1636 S1", attached at the top, bears S52° W, 152.4 feet.

A 5/8" x 24" iron rod set 23" into the ground with a 3/4" brass washer, marked "PLS 1636 NW", attached at ground level, bears N58° W, 86.7 feet.

I hereby certify this corner point was perpetuated as hereon described on October 25, 2002.

Magnetic declination set in compass: 20° E

NAD '83 UTM Zone 11 position: 5042505N 332442E (plus or minus two meters)



Dennis L. Gaylord

Renews June 30, 2003

Recorded at the office of County Surveyor, County of Umatilla, State of Oregon, on:

RECEIVED BY
 Umatilla County Surveyor
 Date 11-02
 Rec'd By KK
 No. 02-267-R