


CERTIFIED RECORD OF LAND CORNER MONUMENTATION

A - 9
DIAGRAM

History of original corner establishment:

The original corner was established by George S. Pershin, deputy, (compassman) on October 4, 1871, under joint GLO contract No. 154, as follows:

Set a stone, 20" x 10" x 6", for the corner to sections 4 and 5, at the intersection of the base line 7 chains and 17 links west of the corner to sections 31 and 32, T. 1 N., R. 29 E.

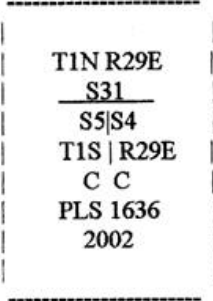

Original corner evidence recovered:

Found the original corner stone loosely set on the north edge of a mound of stones. The corner stone is 22" x 10" x 8" and is plainly marked with four notches on the east edge and "CC" on the south face.

Monument and accessories established to perpetuate the original position of this corner:

In place of the original corner stone, I set a 1" x 18" flared, galvanized iron pipe 12" into the ground to bed rock. A 2 1/2" brass cap attached to the top of the pipe is marked as shown in the diagram above. I bury the corner stone along the northeast side of the pipe and build a mound of stones around the pipe, from which:

A 5/8" x 18" iron rod set 17" into the ground with a 3/4" brass washer, marked "PLS 1636 NE", attached at ground level, bears N57° E, 62.3 feet.

A 5/8" x 18" iron rod set 16" into the ground with a 3/4" brass washer, marked "PLS 1636 S4", attached at ground level, bears S23° 30' E, 106.5 feet.

A 5/8" x 24" iron rod set 23" into the ground with a 3/4" brass washer, marked "PLS 1636 S5", attached at ground level, bears S67° W, 60.5 feet.

A 5/8" x 18" iron rod set 17" into the ground with a 3/4" brass washer, marked "PLS 1636 NW", attached at ground level, bears N8° 30' W, 90.0 feet.

I hereby certify this corner point was perpetuated as hereon described on November 7, 2002.

Magnetic declination set in compass: 18° E. (Base line is visible to the west)

NAD '83 UTM Zone 11 position: 5042708N 325870E (plus or minus two meters)



 REGISTERED PROFESSIONAL LAND SURVEYOR

Dennis L. Gaylord

 OREGON

 JULY 14, 1978

 DENNIS L. GAYLORD

 1636

Renews June 30, 2003

Recorded at the office of County Surveyor, County of Umatilla, State of Oregon, on:

RECEIVED BY
 Umatilla County Surveyor
 Date 11-02
 Rec'd By KE
 No. 02-269-R