

CERTIFIED RECORD OF LAND CORNER MONUMENTATION

V - 11
DIAGRAM

History of original corner establishment:

The original corner was established by George S. Pershin, deputy, (compassman) on November 2, 1871, under joint GLO contract No. 154, as follows:

T1S R30E
1/4 S28
S33
PLS 1636
2003

Set a stone, 20" x 8" x 4", for the 1/4 section corner to sections 28 and 33. Va: 19° 33' East.

Original corner evidence recovered:

Found the original corner stone loosely set in a mound of stones. The corner stone is 20" x 13" x 4" and is plainly marked "1/4" on one face.

Monument and accessories established to perpetuate the original position of this corner:

In place of the original corner stone, I set a 1" x 30" flared, galvanized iron pipe 20" into the ground to bedrock. A 2 1/2" brass cap attached to the top of the iron pipe is marked as shown in the diagram above. I bury the corner stone along the east side of the pipe and build a mound of stones around the pipe, from which:

A 5/8" x 24" iron rod, set 23" into the ground with a 3/4" brass washer, marked "PLS 1636 NE", attached at ground level, bears N24° E, 75.5 feet.

A 5/8" x 24" iron rod, set 23" into the ground with a 3/4" brass washer, marked "PLS 1636 SE", attached at ground level, bears S61° 30' E, 70.4 feet,


A 5/8" x 24" iron rod, set 23" into the ground with a 3/4" brass washer, marked "PLS 1636 SW", attached at ground level, bears S42° W, 98.5 feet.

A 5/8" x 24" iron rod, set 23" into the ground with a 3/4" brass washer, marked "PLS 1636 NW", attached at ground level, bears N53° 30' W, 66.8 feet.

I hereby certify the above corner point was perpetuated as hereon described on March 10, 2003.

Magnetic declination set in compass: 14°E. (Section corner to east is visible)

NAD '83 UTM Zone 11 position: 5034395N 336243E (plus or minus two meters)

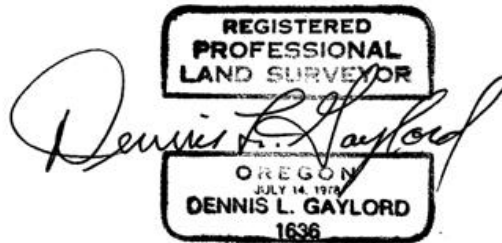

Renews June 30, 2003

Recorded at the office of County surveyor, County of Umatilla, State of Oregon, on:

RECEIVED BY
Umatilla County Surveyor
Date 5-03
Rec'd By KK
No. 03-69-R