

OREGON CORNER RESTORATION FORM

Section 1 Township 1S Range 30E
 County Umatilla Date: August 29, 2001

Corner Designation: 1S30A25

Closing corner to Township 1 south Ranges 30 and 30 1/2 East, W.M., Umatilla County, Oregon.

Condition Report Only
 Not found
 Remonumented
 Unrecorded
 Surveyed in
 Referenced out


Previous Renewals / Surveys, etc.

The corner was originally set by George Pershin and George Williams under contract No. 154 dated June 6, 1871. Their record reads: Set a stone, 24 x 6 x 5 at point of intersection for cor. to Tps. 1, S., Rs. 30 & 31 E., raised a mound of stone as per instructions.


Monument and Accessories found: (condition and source)

The original stone firmly in place and plainly notched and marked CC. There were no other stones around to indicate the mound had ever been built.

DIAGRAM

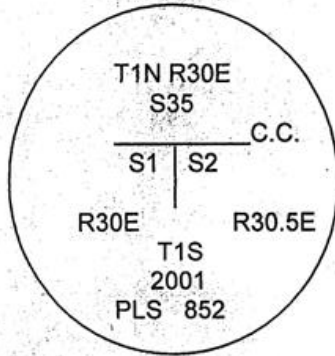

SKETCH

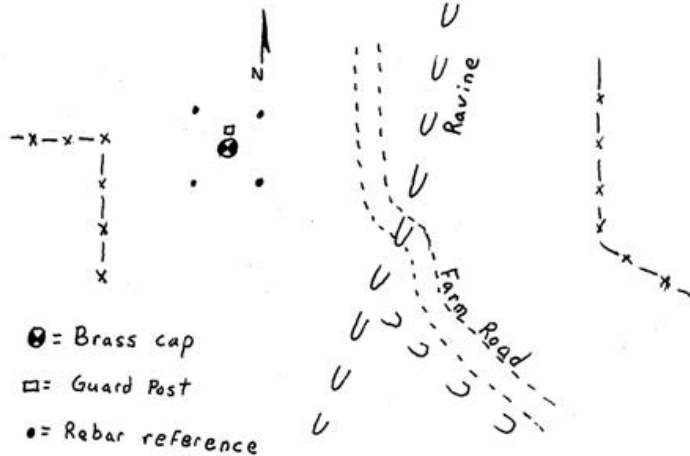

⊙ = Brass cap
 □ = Guard Post
 ● = Rebar reference

MONUMENT (S) AND ACCESSORIES SET (Procedures and Description)

At the position of the original stone I set a 30" x 1 1/8" G.I.P. with a 2 1/2" brass cap stamped as shown in the diagram above flush with the ground. I set a 5' steel guard post with a County monument sign attached along side.

For references, I set four 5/8" by 24" rebars with 1 1/4" red plastic caps stamped ORLS 852, and WALS 13922 as described below:

- an iron rebar bears N38°45'44"W, 22.21 feet;
- an iron rebar bears N46°21'02"E, 23.04 feet;
- an iron rebar bears S39°36'08"E, 19.64 feet;
- an iron rebar bears S38°06'33"W, 22.29 feet;

The monument and references were tied using a LIECA SYSTEM 300 RTK GPS.

Location and comments
 OR SPC Oregon North 1983-91
 N = 677654.59
 E = 8581201.20

Compass Declination

Surveyors Seal

RECEIVED BY:
Umatilla County Surveyor
 Date: 12/20/2001
 Rec'd By: WHA
 No. 01-206-C

Firm / Agency
 Haddock Surveying
 Address
 P.O. Box 1574
 Pendleton, Or. 97801
 Party Chief
 Stephen K, Haddock

**REGISTERED
 PROFESSIONAL
 LAND SURVEYOR**

David L. Haddock

**OREGON
 JULY 12, 1999
 DAVID L. HADDOCK
 852**

RENEWS 6-30-03