

OREGON CORNER RESTORATION FORM

Section 18 Township 1S Range 31E
 County Umatilla Date: September 25, 2001

Corner Designation: 1S31L1

Condition Report Only
 Not found
 Remonumented
 Unrecorded
 Surveyed in
 Referenced out


1/4 corner to section 18 T1S, R31E and section 13 T1S, R30 1/2E, W.M., Umatilla County, Oregon.

Previous Renewals / Surveys, etc.

Corner originally set by David P. Thompson under contract No. 106 Dated August 16, 1864. His record reads: Set a stone, 15 x 10 x 8 for 1/4 Secs. Cor..

Monument and Accessories found: (condition and source)

The intersection of a North - South fence line with the right of way centerline of County Road No. 632 (Stock Drive Road) as per the road notes of said County Road.

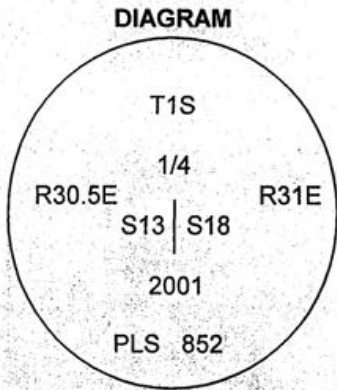

MONUMENT (S) AND ACCESSORIES SET (Procedures and Description)

I determined the right of way centerline as midway between the right of way fences and held the intersection of this line with the line of the North - South fence along the township line. At the corner I set a 1 1/4" x 12" Galvanized Iron Pipe with a 2 1/2" brass cap stamped as shown in the diagram above in an 18" diam. x 12" depth concrete plug in the bedrock. The brass cap was set over a railroad spike driven in the bedrock prior to pouring the concrete.

For references, I set four 5/8" by 24" rebars with 1.25" red plastic caps stamped ORLS 852 and WAL5 13922 as described below:

- an iron rebar bears N38°49'17"E, 47.30 feet, at the corner of a rock jack;
- an iron rebar bears N53°15'33"W, 50.67 feet, under the existing fence;
- an iron rebar bears S66°40'20"W, 69.92 feet, under the existing fence;
- an iron rebar bears S34°04'17"E, 35.26 feet, near a railroad tie fence corner;

This monument and references were set and tied used a LIECA system 300 RTK GPS

Location and comments
 OR SPC 83-91
 N = 664564.95
 E = 8587434.15

Compass Declination

Surveyors Seal

RECEIVED BY:
Umatilla County Surveyor
 Date: 12/20/2001
 Rec'd By: DHK
 No. 01-206-C

Firm / Agency
 Haddock Surveying
 Address
 P.O. Box 1574
 Pendleton, Or. 97801
 Party Chief
 Stephen K, Haddock



RENEWS 6-30-03