

OREGON CORNER RESTORATION FORM

Section 3 Township 1S Range 31E
 County Umatilla Date: October 3, 2001

Corner Designation: 1S31A15

North 1/4 section corner to section 3, T1S, R31E,
 W.M., Umatilla County, Oregon.


Condition Report Only
 Not found
 Remonumented
 Unrecorded
 Surveyed in
 Referenced out

Previous Renewals / Surveys, etc.

The corner was originally set by David P. Thompson under contract No. 106 dated August 16, 1864. His record reads: Set post for 1/4 sec. closing corner in mound of earth with charred stake, pits, trench and C. as per instructions. The County Surveyor, Aubrey Perry, in the survey recorded in Book 2, at Page 301 of the Record of Private Surveys, calls for "fence running S. - Rock 25" x 14" x 6" ".

Monument and Accessories found: (condition and source)

All that remains of the fence is two rock jacks which appear to be either side of a gate. A power line runs south from this point. I found no trace of the stone.

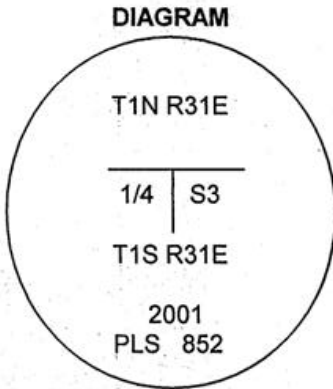

MONUMENT (S) AND ACCESSORIES SET (Procedures and Description)

At the proportionate point I set a 30" x 1 1/2" G.I.P. with a 2 1/2" brass cap stamped as shown in the diagram above flush with the surface. I set a 5' steel guard post with a County monument sign attached along side.

For references, I set four 5/8" by 24" rebars with 1 1/4" red plastic caps stamped ORLS 852, and WALS 13922 as described below:

- an iron rebar bears N6°53'22"E, 26.01 feet, 20" below the surface;
- an iron rebar bears S89°04'30"E, 25.88 feet, 20" below the surface;
- an iron rebar bears S4°02'56"W, 22.92 feet;
- an iron rebar bears S89°37'09"W, 21.45 feet;

The monument and references were tied using a LIECA SYSTEM 300 RTK GPS.

Location and comments
 OR SPC Oregon North 1983-91
 N = 677994.37
 E = 8605727.35

Compass Declination

Surveyors Seal

RECEIVED BY:
Umatilla County Surveyor
 Date: 12/20/2001
 Rec'd By: DHC
 No. 01-206-C

Firm / Agency
 Haddock Surveying
 Address
 P.O. Box 1574
 Pendleton, Or. 97801
 Party Chief
 Stephen K, Haddock

REGISTERED
 PROFESSIONAL
 LAND SURVEYOR

David L. Haddock

OREGON
 JULY 12, 1966
 DAVID L. HADDOCK
 852

RENEWS 6-30-03