


CERTIFIED RECORD OF LAND CORNER MONUMENTATION

Corner to Sections 1 and 2, T1S, R31E, W M.

Index: 1S 31 A-21

DIAGRAM

History of original corner establishment:
Corner originally set by Thompson in contract 106 dated 1864.
His record reads: 80.00 Set stone 24x12x5 for corner to
secs. 1 and 2.

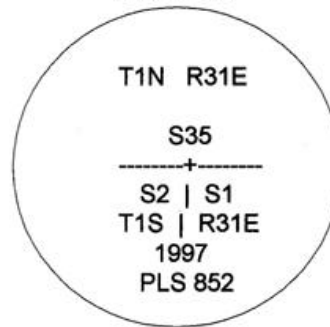

Evidence Found: Found record size stone at corner of west and south fences. Stone was buried on end for half its depth in vertical position but there were no visible markings. The stone was in a large stone mound at intersection of fences running west and south.

Description of monument and accessories I established to perpetuate the original location of this corner:

At the position of the stone, I set a 1.25" x 30" galvanized iron pipe with 2.25" brass cap stamped as shown in the diagram, flush with the ground.

I set four 5/8" by 24" rebars with 1.25" red plastic caps stamped ORLS 852 and WALS 13922 as described below:

- a rebar bears S88°56'E, 36.09 feet 18" below the surface;
- a rebar bears N01°21'W, 36.87 feet 18" below the surface;
- a rebar bears S01°09'E, 36.06 feet under the fence;
- a rebar bears S89°50'W, 38.79 feet under the fence;

The bearings are true.

This work was done May 15, 1997, and witnessed by Stephen K. Haddock and Darrel Bigelow.

Office of _____, I hereby certify that the within instrument was filed
 State of _____
 in this office for record on the _____ day of _____ by _____
 _____ (COUNTY OFFICIAL) (DEPUTY)

County of Umatilla



David L. Haddock



RECEIVED BY
 Umatilla County Surveyor
 Date 7-97
 Rec'd By KK
 No. 97-140-C