

OREGON CORNER RESTORATION FORM

Section 1 Township 1S Range 31E
 County Umatilla Date: October 2, 2001

Corner Designation: 1S31A23

North 1/4 section corner to section 1, T1S, R31E,
 W.M., Umatilla County, Oregon.


Previous Renewals / Surveys, etc.

The corner was originally set by David P. Thompson under contract No. 106 dated August 16, 1864. His record reads: Set post for 1/4 sec. corner in mound of earth with charred stake, pits, trench and C. as per instructions.


Monument and Accessories found: (condition and source)
 None.

Condition Report Only
 Not found
x Remonumented
 Unrecorded
 Surveyed in
x Referenced out

DIAGRAM

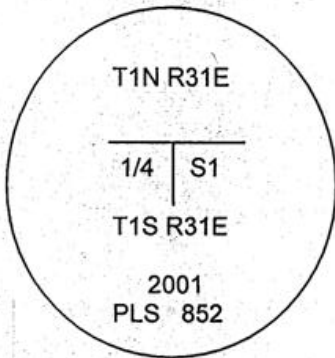

SKETCH

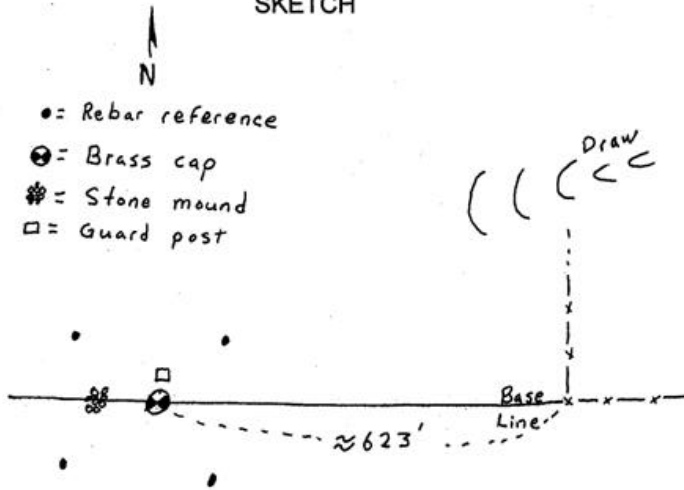

MONUMENT (S) AND ACCESSORIES SET (Procedures and Description)

At the proportionate point I set a 2 1/2" Brass cap on a 30" x 1 1/2" G.I.P. flush with the ground with a 5' steel guard post with a County monument sign attached along side. The point falls in a CRP field on a gentle rolling ridge top with no distinguishable features near. I made a mound of stones approximately 3 feet west of the corner. The cap was stamped as shown in the diagram above.

For references, I set four 5/8" by 24" rebars with 1 1/4" red plastic caps stamped ORLS 852, and WALS 13922 as described below:

- an iron rebar bears N40°17'07"E, 22.56 feet, 18" below the surface;
- an iron rebar bears S51°29'54"E, 21.80 feet, 18" below the surface;
- an iron rebar bears N49°48'48"W, 24.36 feet, 18" below the surface;
- an iron rebar bears S42°07'17"W, 24.74 feet, 18" below the surface;

The monument and references were tied using a LIECA SYSTEM 300 RTK GPS.

Location and comments
 OR SPC Oregon North 1983-91
 N = 678141.30
 E = 8616265.40

Compass Declination

Surveyors Seal

RECEIVED BY:
Umatilla County Surveyor
 Date: 12/20/2001
 Rec'd By: DHK
 No. 01-206-C

Firm / Agency
 Haddock Surveying
 Address
 P.O. Box 1574
 Pendleton, Or. 97801
 Party Chief
 Stephen K, Haddock



David L. Haddock



RENEWS 6-30-03