

OREGON CORNER RESTORATION FORM

Section 6 Township 1S Range 31E
 County Umatilla Date: September 20, 2001

Corner Designation: 1S31C1

Condition Report Only

1/4 corner to section 6 T1S, R31E and section 1
 T1S, R30 1/2E, W.M., Umatilla County, Oregon.



Remonumented
 Unrecorded
 Surveyed in
 Referenced out

Previous Renewals / Surveys, etc.

Corner originally set by David P. Thompson under contract No. 106 Dated August 16, 1864.
 His record reads: Set a stone, 15 x 8 x 8 for 1/4 Secs. Cor..

Monument and Accessories found: (condition and source)

A mound of stone along side a railroad tie fence corner with a record dimension stone with no visible markings. There were not enough stones to have been a rock jack. The mound had been disturbed.

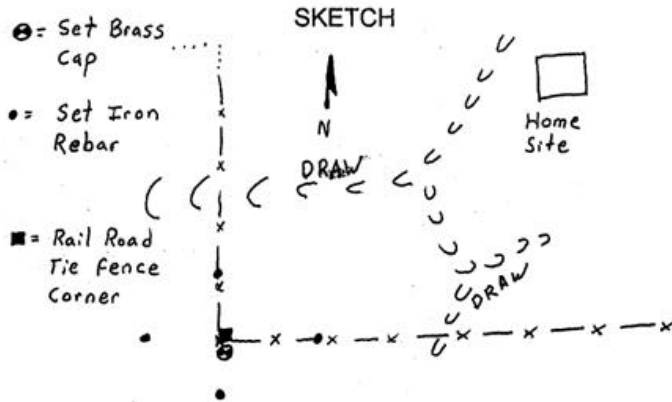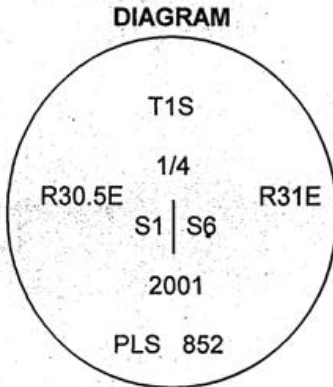

MONUMENT (S) AND ACCESSORIES SET (Procedures and Description)

I accepted the fence corner due to it's relation to the record distances, the record size stone, and the testimony of Mr. John Owen, the landowner to the south, who stated that this corner has not moved in the last 25 years. At the corner I set a 1 1/4" x 30" Galvanized Iron Pipe with a 2 1/2" brass cap stamped as shown in the diagram above.

For references, I set four 5/8" by 24" rebar with 1.25" red plastic caps stamped ORLS 852 and WAL5 13922 as described below:

- an iron rebar bears N3°15'47"W, 24.89 feet, 18" below the surface;
- an iron rebar bears S89°43'47"E, 24.05 feet, under the existing fence;
- an iron rebar bears S0°55'39"E, 25.81 feet, 18" below the surface;
- an iron rebar bears N88°16'32"W, 26.99 feet, 18" below the surface;

This monument and references were set and tied used a LIECA system 300 RTK GPS

Location and comments
 OR SPC 83-91
 N = 675132.43
 E = 8587260.56

Compass Declination

Surveyors Seal

RECEIVED BY:
Umatilla County Surveyor
 Date: 12/20/2001
 Rec'd By: WHS
 No. 01-206-e

Firm / Agency
 Haddock Surveying
 Address
 P.O. Box 1574
 Pendleton, Or. 97801
 Party Chief
 Stephen K, Haddock



David L. Haddock



RENEWS 6-30-03