

OREGON CORNER RESTORATION FORM

Section 35 Township 1S Range 31E
 County Umatilla Date: March 22, 2011

Corner Designation: 1S31X17

Condition Report Only

- Not found
- Remonumented
- Unrecorded
- Surveyed in
- Referenced out


Common quarter corner to sections 34 and 35, T1S, R31E, W.M., Umatilla County, Oregon.

Previous Renewals / Surveys, etc.

Corner originally set by Daniel Chaplin under contract No. 107 dated September 21, 1864. His record reads: Set post for 1/4 Sec. Cor., in mound of earth, with charred stake, pits, etc. as per instructions. John Kimbrell in the record of private surveys Book 2, Page 223 says: Set stone 15x8x7 for 1/4 Sec. Cor. He then ran the line west through the center of Section 34.

Monument and Accessories found: (condition and source)

A fence intersection with fences running North, South, and East. The fence to the west is now only remains consisting of old wooden posts and rock jacks.

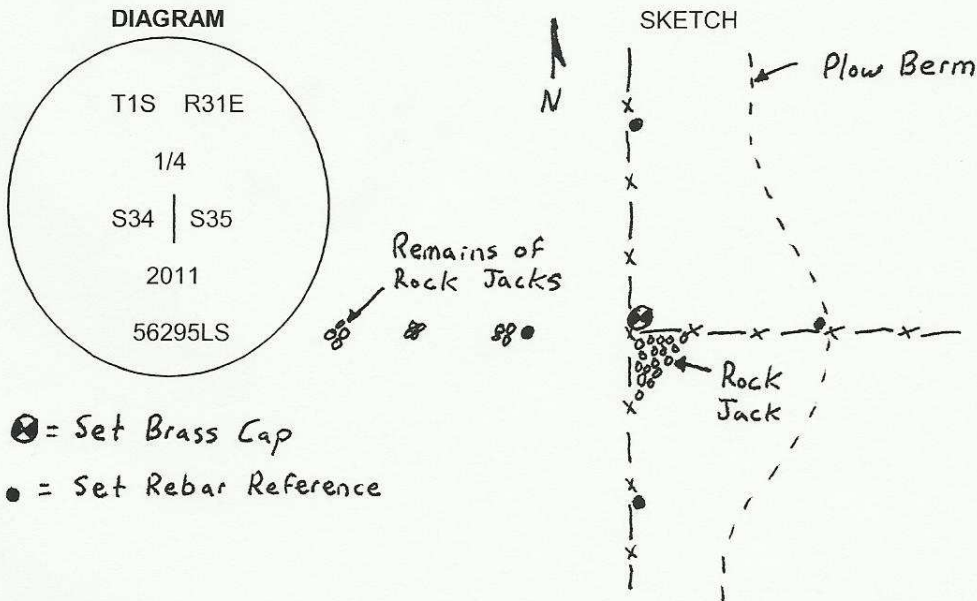

MONUMENT (S) AND ACCESSORIES SET (Procedures and Description)

I held the fence intersection and at the corner point I set a 2 3/8" brass cap on a 1 1/2" x 18" galvanized iron pipe 18 inches into the ground to bedrock.

For references, I set four 5/8" by 24" rebars with 1.25" orange plastic caps stamped WTS and 56295LS as described below:

- an iron rebar bears N02°56'41"W, 26.91 feet under the existing fence;
- an iron rebar bears S87°31'54"E, 70.00 feet under the existing fence;
- an iron rebar bears S01°19'09"E, 40.57 feet under the existing fence;
- an iron rebar bears S89°10'10"W, 61.57 feet on line with the old fence to the west;

The monument and references were tied using a Trimble R7/R8 RTK GPS system.

Location and comments

Compass Declination

Surveyors Seal

RECEIVED BY:
Umatilla County Surveyor
 Date: _____
 Rec'd By: _____
 No. 11-112-C

Firm / Agency
 Witness Tree Surveying
 Address
 P.O. Box G
 Pilot Rock, OR 97868
 Party Chief
 Stephen K, Haddock

REGISTERED
 PROFESSIONAL
 LAND SURVEYOR

Stephen K. Haddock

OREGON
 JULY 9, 2001
 STEPHEN K. HADDOCK
 56295LS

RENEWAL DATE 6-30-13