


CERTIFIED RECORD OF LAND CORNER MONUMENTATION

History of original corner establishment:

The original corner was established by David P. Thompson on October 6, 1864, under GLO contract No. 106, as follows:

Set a stone 17" x 8" x 8" for the corner to sections 2, 3, 34 and 35.

A - 17
DIAGRAM

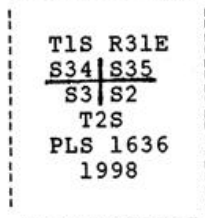

Corner evidence recovered:

The original corner stone is loosely set in a mound of stones. The stone is 16" x 11" x 7" and is plainly marked with two notches on one edge.

Monument and accessories established to perpetuate the original location of this corner:


At the point occupied by the original corner stone, I set a 1" x 30" iron pipe, 14" into the ground to bedrock. I bury the corner stone along the south side of the pipe and build a mound of stones around the pipe to the cap. A 2 1/2" brass cap attached is marked as shown in the diagram above, from which:

A 5/8" x 36" iron rod set 36" into the ground with a 3/4" brass washer attached at ground level, marked "PLS 1636 NE", bears N5°E, 90.1 feet.
A 5/8" x 24" iron rod set 27" into the ground with a 3/4" brass washer attached 4" below the ground surface, marked "PLS 1636 SE", bears S55°E, 133.5 feet.

A 5/8" x 36" iron rod set 29" into the ground with a 3/4" brass washer attached at ground level, marked "PLS 1636 SW", bears S79°W, 66.6 feet.

A 10" Juniper, scribed "T1S R31E S34 BT" on triple blazes with a 3/4" brass washer, marked "PLS 1636", nailed flush to the scribed "B", bears N36°W, 239.9 feet. This tree also has a "Bearing Object" sign nailed above the blazes.

I hereby certify the above corner point was perpetuated as hereon described on March 21, 1998. Magnetic declination: 18°E.

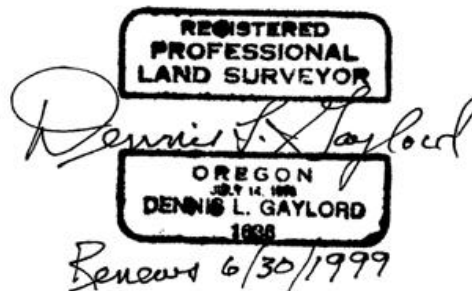

Recorded at the office of County Surveyor, County of Umatilla, State of Oregon, on _____, 1998.

RECEIVED BY
 Umatilla County Surveyor
 Date 4-98
 Rec'd By KK
 No. 98-44-R