

OREGON CORNER RESTORATION FORM

Section 1 Township 2S Range 31E
 County Umatilla Date: April 5, 2011

Corner Designation: 2S31A21

Condition Report Only

Not found

Remonumented

Unrecorded

Surveyed in

Referenced out


Corner to sections 35 and 36, T1S, R31E, and sections 1 and 2, T2S, R31E, W.M., Umatilla County, Oregon.

Previous Renewals / Surveys, etc.

Corner originally set by David P. Thompson under contract No. 106 dated August 16, 1864. His record reads: Set stone 18x8x4 for Cor. to Secs. 1, 3, 35, and 36.

Monument and Accessories found: (condition and source)

None. The point falls in a plowed field and the creek has meandered from being on the west of the corner point to being on the east side of the corner. There are long term fence lines running to the west and north that constitute the best available evidence for the corner point. The projected fence intersection falls 12 feet west of the proportioned point.

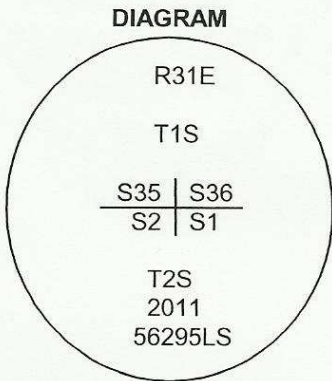

SKETCH

County Road Grade
 Plow Lines
 Bear Creek

⊗ = Set Brass Cap
 ● = Rebar Reference

MONUMENT (S) AND ACCESSORIES SET (Procedures and Description)

At the projected fence intersection I set a 2 3/8" brass cap on a 1 1/2"x30" galvanized iron pipe 22 inches below the surface of the plowed field.

For references, I set four, 5/8" by 24" rebars with 1.25" orange plastic caps stamped WTS and 56295LS as described below:

- an iron rebar bears S88°01'30"E, 28.22 feet, 22 inches below the surface of the field;
- an iron rebar bears S02°34'38"E, 26.40 feet, 22 inches below the surface of the field;
- an iron rebar bears N89°14'10"W, 264.00 feet under a gate in the existing fence;
- an iron rebar bears N00°06'12"E, 627.00 feet on the east side of the existing fence;

The monument and references were tied using a Trimble R7/R8 RTK GPS system.

Location and comments

Compass Declination

Surveyors Seal

RECEIVED BY:
 Umatilla County Surveyor
 Date: _____
 Rec'd By: _____
 No. 11-112-c

Firm / Agency
 Witness Tree Surveying
 Address
 P.O. Box G
 Pilot Rock, Or. 97868
 Party Chief
 Stephen K, Haddock

REGISTERED
 PROFESSIONAL
 LAND SURVEYOR

Stephen K. Haddock

OREGON
 JULY 9, 2001
 STEPHEN K. HADDOCK
 56295LS

RENEWAL DATE 6-30-13