


CERTIFIED RECORD OF LAND CORNER MONUMENTATION

Closing corner to Section 6, T1S, R32E.
and Section 1, T1S, R31E, W M.

Index: 1S 32 A-1

DIAGRAM

History of original corner establishment:
Corner originally set by Thompson in contract 106 dated 1864. His record reads: 80.81 Intersect Base Line and set post for Cor. to Tp. 1 S., Rs. 31 & 32 E., in mound of earth with charred stake, pits, trench, etc., as per instructions. The intersection is 950 lks. W. of Tp. Cor. to Tp. 1 N., Rs. 31 & 32.

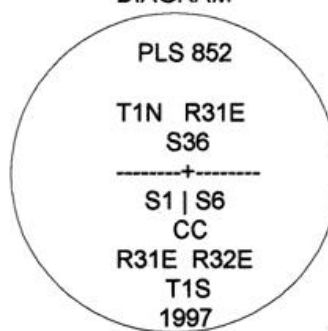

Evidence Found: Found mound of stones by an old fence corner 9.643 chains west of Corner to T1N, R31 and 32E. Record - 9.50 chains. Point is 79.836 chains east of the found stone at the northwest corner of Section 1, T1S, R31E. Record - 80.00 chains.

Description of monument and accessories I established to perpetuate the original location of this corner:

At the center of the mound, I set a 1.25" x 30" galvanized iron pipe, with 2.25" brass cap stamped as shown in the diagram, flush with the ground and with a collar of stone.

I set four 5/8" by 24" rebars with 1.25" red plastic caps stamped ORLS 852 and WAL5 13922 as described below:

- a rebar bears S89°26'E, 35.49 feet under the east bound fence;
- a rebar bears N5°43'W, 29.12 feet 18" below the surface in a plowed field;
- a rebar bears S2°10'W, 25.13 feet 18" below the surface in a plowed field;
- a rebar bears N89°47'W, 34.93 feet under the west bound fence;

The bearings are true.

This work was done May 14, 1997, and witnessed by Stephen K. Haddock and Darrel Bigelow.

Office of _____, I hereby certify that the within instrument was filed
County of Umatilla
State of _____
in this office for record on the _____ day of _____ by _____
_____(COUNTY OFFICIAL) _____ (DEPUTY)

REGISTERED
PROFESSIONAL
LAND SURVEYOR

David L. Haddock

OREGON
JULY 12, 1999
DAVID L. HADDOCK
882

RECEIVED BY
Umatilla County Surveyor
Date 7-97
Rec'd By SK
No. 97-140-C