


CERTIFIED RECORD OF LAND CORNER MONUMENTATION

Corner to Sections 3 and 4, T1S, R32E, W M.

Index: 1S 32 A-13

DIAGRAM

History of original corner establishment:  
Corner originally set by Thompson in contract 106 dated 1864.  
His record reads: 80.00 Set post for corner to secs. 3 and 4  
in mound of earth with charred stake, pits, trench &c as per  
instructions.

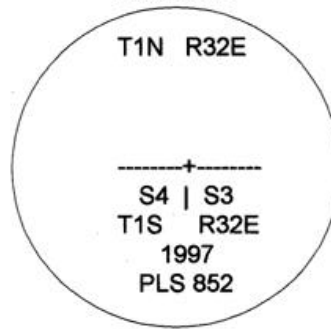

Record of Private Surveys, book 2, page 299 records that  
Umatilla County Surveyor, Aubrey Perry reset this corner in  
His record reads:  
Chained 17.95 chains west from cor. and dug to find stake.  
Couldn't find it so I set a rock 8x10x14 marked ||| on W and |||  
on E cor C.C. to Sec. 3 - 4 - Tp. 1 S R 32 E.

Evidence Found: Found Mr. Perry's stone 18" below surface under an east - west fence line.  
A 3" iron pipe set by PLS 1333 under survey I-44-B bears S89°52'E, 49.69 feet.

Description of monument and accessories I established to perpetuate the  
original location of this corner:  
At the position of the stone, I set a 1.25" x 30" galvanized iron pipe with a 2.25" brass cap,  
stamped as shown in the diagram, 26" in the ground with a collar of stone.  
I set three 5/8" by 24" rebars with 1.25" red plastic caps stamped ORLS 852 and WALS 13922 as  
described below:  
a rebar bears N89°49'W, 165.87 feet at a fence junction;  
a rebar bears S89°59'W, 66.15 feet under a west bound fence;  
a rebar bears S89°22'E, 100.68 feet under the east bound fence;

The bearings are true.

This work was done June 11, 1997, and witnessed by Stephen K. Haddock.

Office of \_\_\_\_\_, I hereby certify that the within instrument was filed  
State of \_\_\_\_\_ County of Umatilla  
in this office for record on the \_\_\_\_\_ day of \_\_\_\_\_ by \_\_\_\_\_  
\_\_\_\_\_( COUNTY OFFICIAL ) \_\_\_\_\_ ( DEPUTY )

REGISTERED  
PROFESSIONAL  
LAND SURVEYOR

*David L. Haddock*

OREGON  
JULY 12, 1966  
DAVID L. HADDOCK  
882

RECEIVED BY  
Umatilla County Surveyor  
Date 7-97  
Rec'd By SH  
No. 97-140-C